


T.2S. R.2E.W.M.

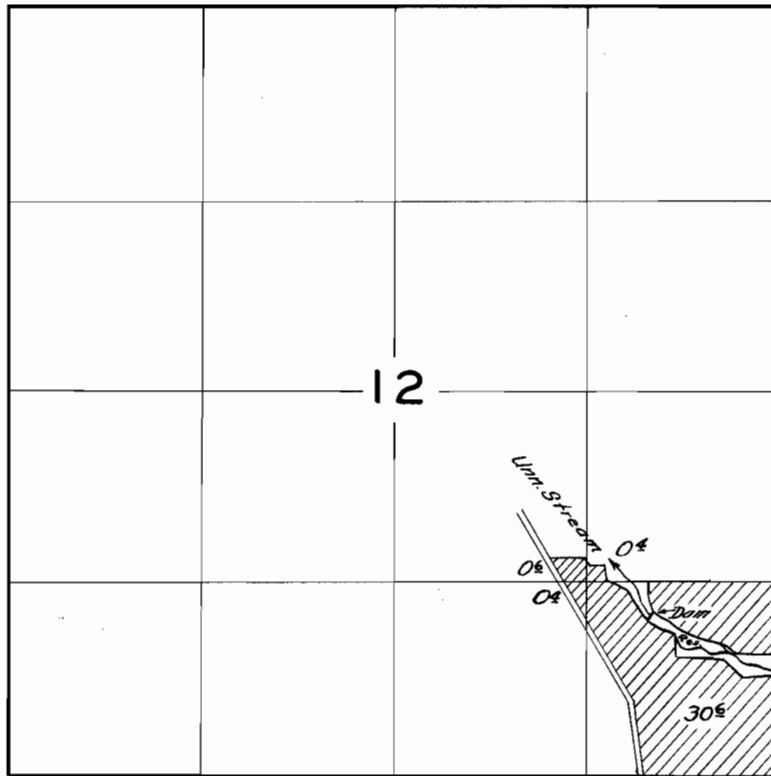

FINAL PROOF SURVEY

UNDER

Application No. ^{R-26497} ~~26498~~ Permit No. ^{R-1261} ~~20766~~

IN NAME OF

G. F. & DORA HABERLACH

Surveyed May 14 1956, by M. B. Bish

DFK-10-76