


T. 3S. R. 3E. W.M.

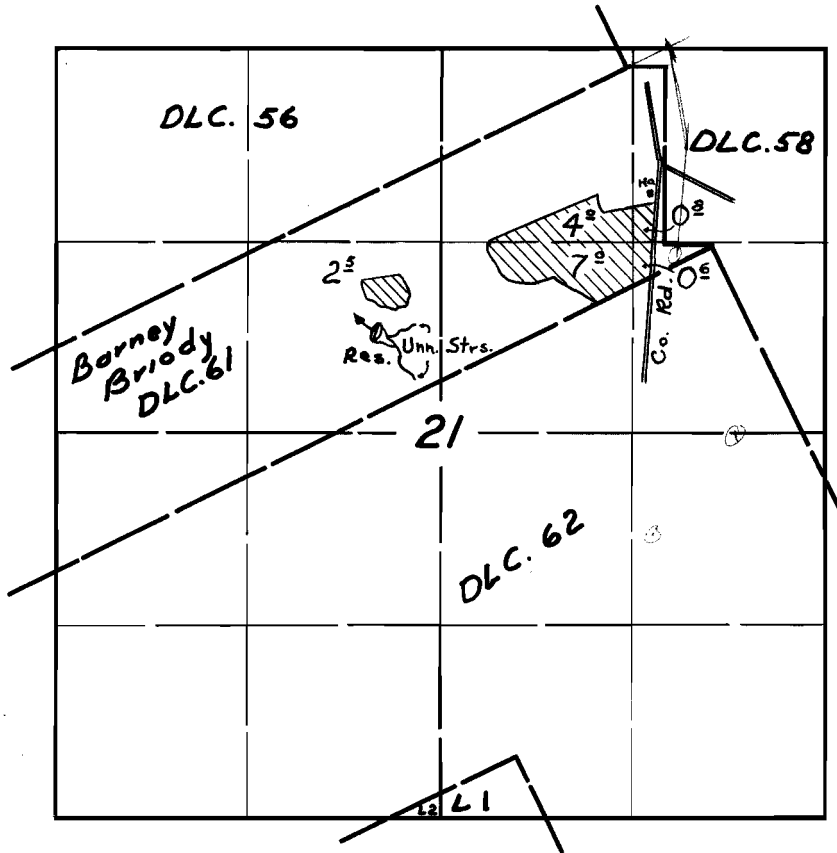

FINAL PROOF SURVEY

UNDER

R-26618

R-1277

Application No. 26619 Permit No. 20844

IN NAME OF

R. H. RAMBO

Surveyed 28 Aug. 1956, by M. Bish

DFK-1D-129

Boyo