


T.5S.R.3W.W.M.

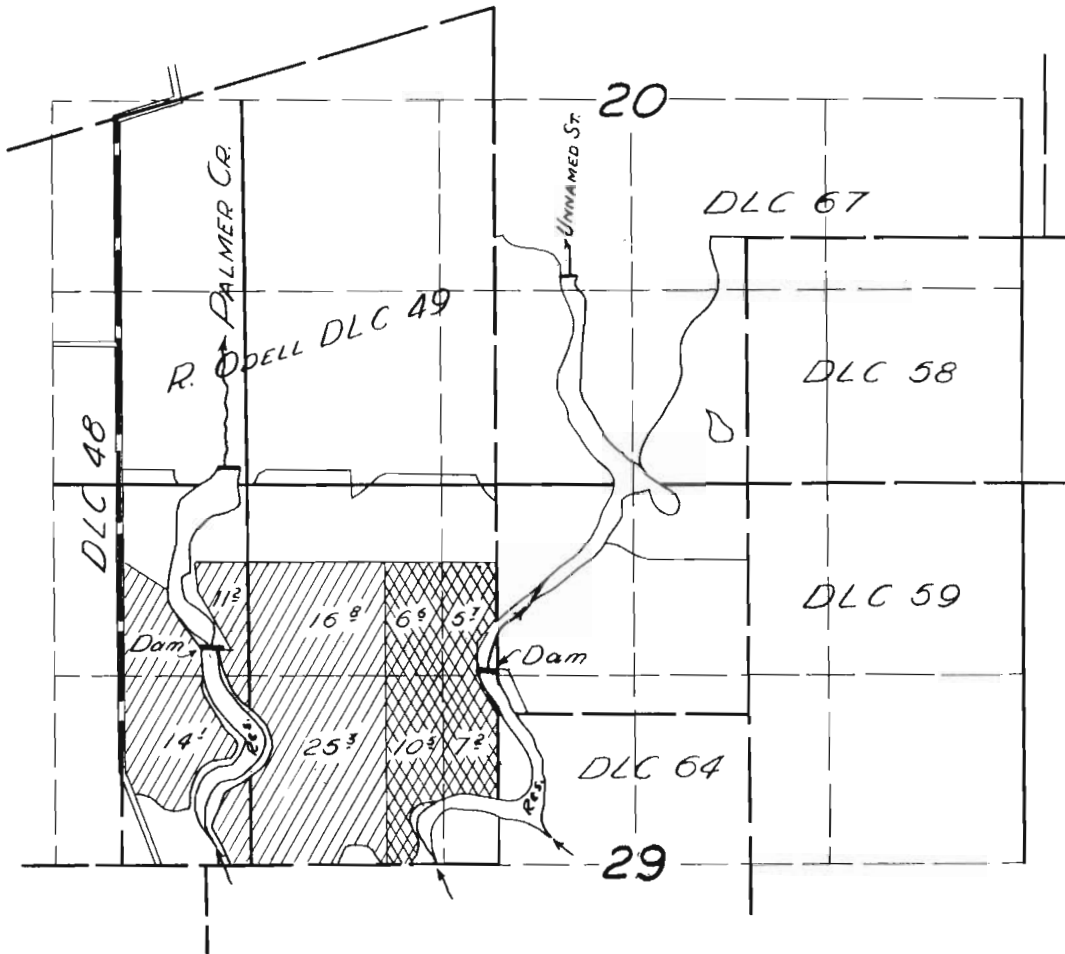

FINAL PROOF SURVEY

23304 18438 }
R-23303 R-952 }
26647 21014 }
Application No. R-26380 Permit No. R-1308 }

IN NAME OF
VICTORIA CAMPBELL

Surveyed 26 Mar 1956, by *[Signature]*

[Handwritten mark]