


T. 2 S. R. 4 E. W. M.

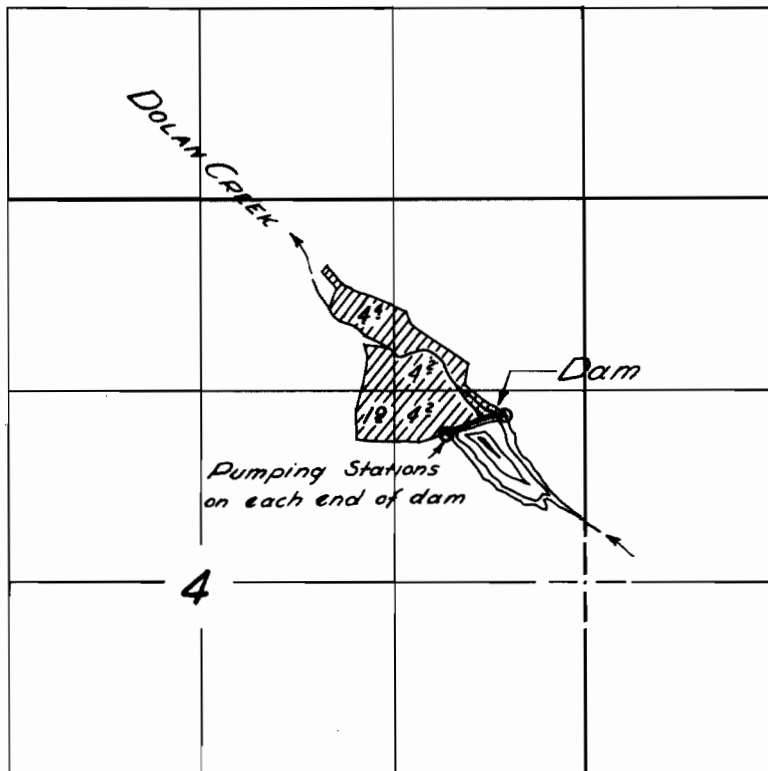

FINAL PROOF SURVEY

UNDER

R-26866

R-1326

Application No. 26867 Permit No. 21097

IN NAME OF

EUGENE L. WELLING

Surveyed 25 June 1956, by C. W. Welling