


T. 3 S., R. 2 W., W. M.

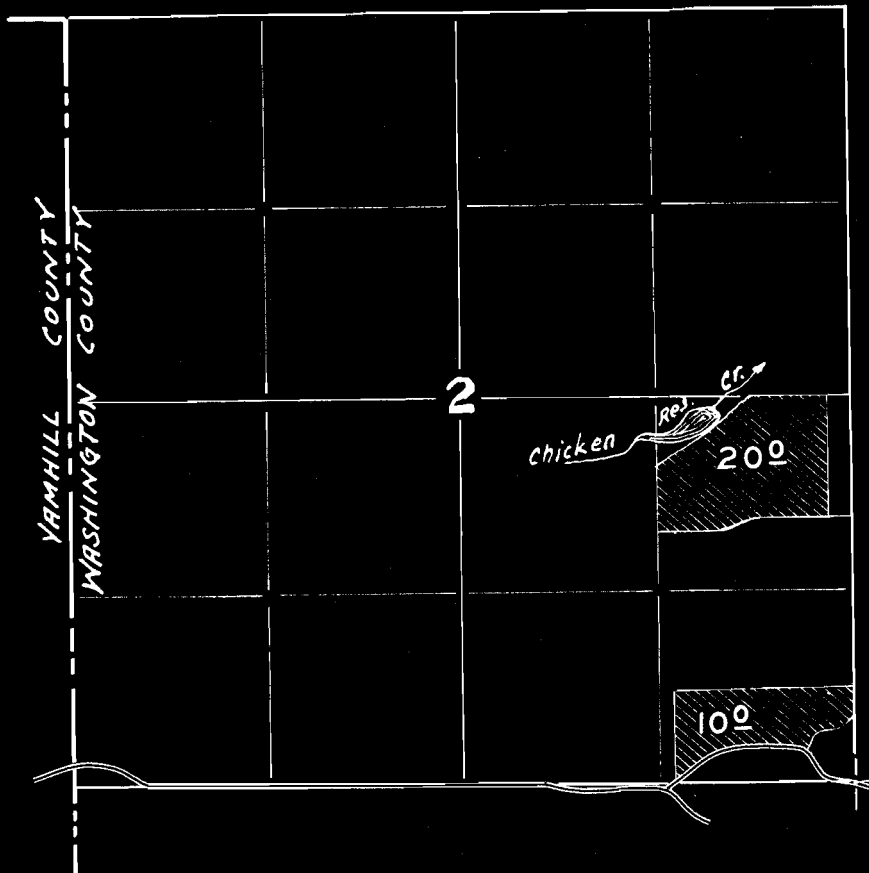

FINAL PROOF SURVEY

UNDER

R-26872

R-1327

Application No. 27046 Permit No. 2111

IN NAME OF

MILBURN ZIEGLER

Surveyed 5 - 9 1956, by M. BISH