


T. 5S. R. 3E. W.M.

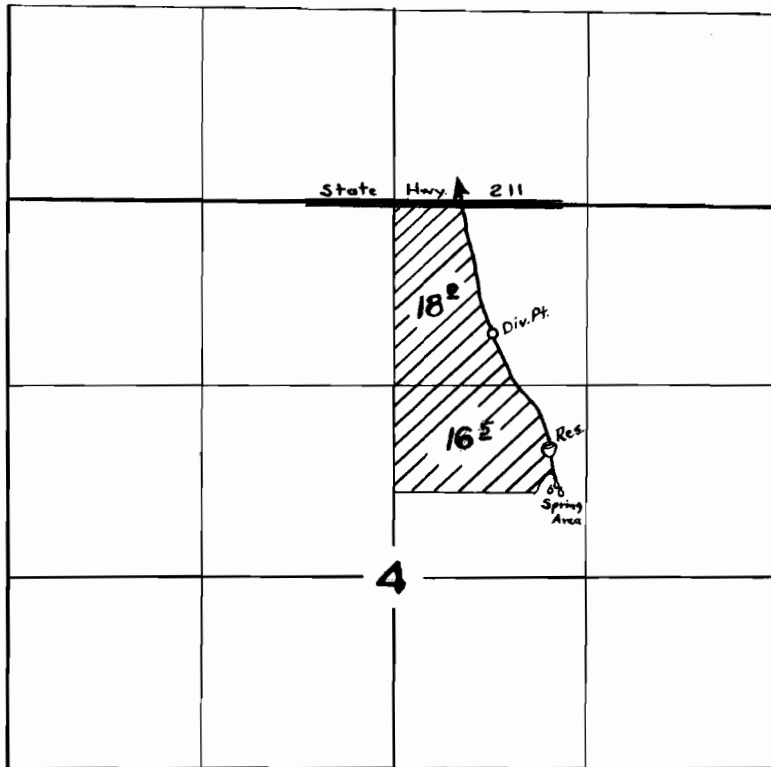

**FINAL PROOF SURVEY**

UNDER

R-27023

R-1357

Application No. 27024 Permit No. 21268

IN NAME OF

ARNO SCHELLER

Surveyed 29 MAR. 1956, by R.D. BEST

*Handwritten initials*