


T. 5S. R. 1E. W.M.

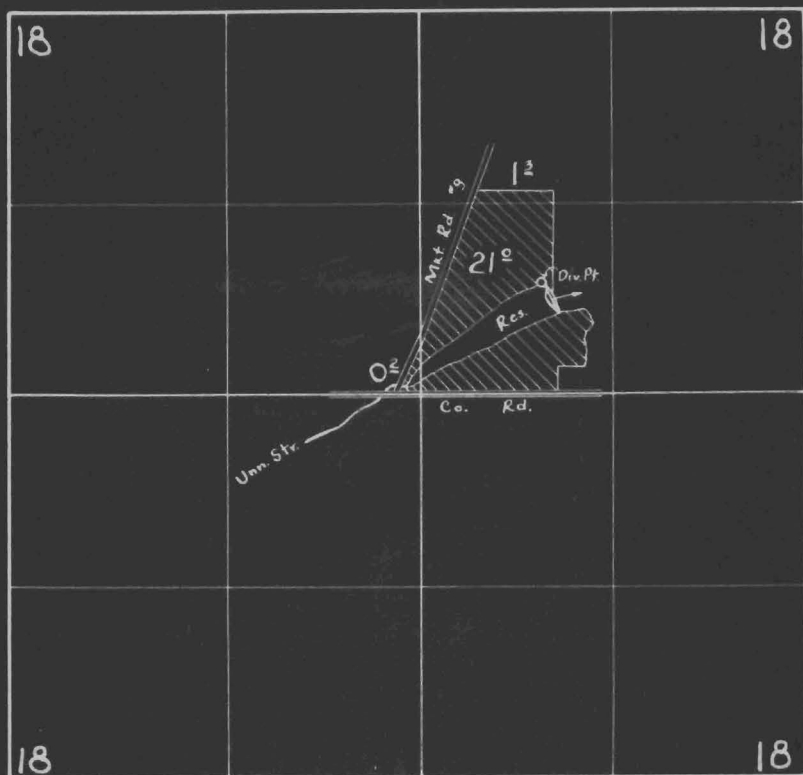

FINAL PROOF SURVEY

UNDER

R-27411 R-1424
Application No. 27412 Permit No. 21724

IN NAME OF

Warren W. Bremer

Surveyed 6 Mar. 1956, by R. D. Best