


T.2S.,R.3W., W.M.

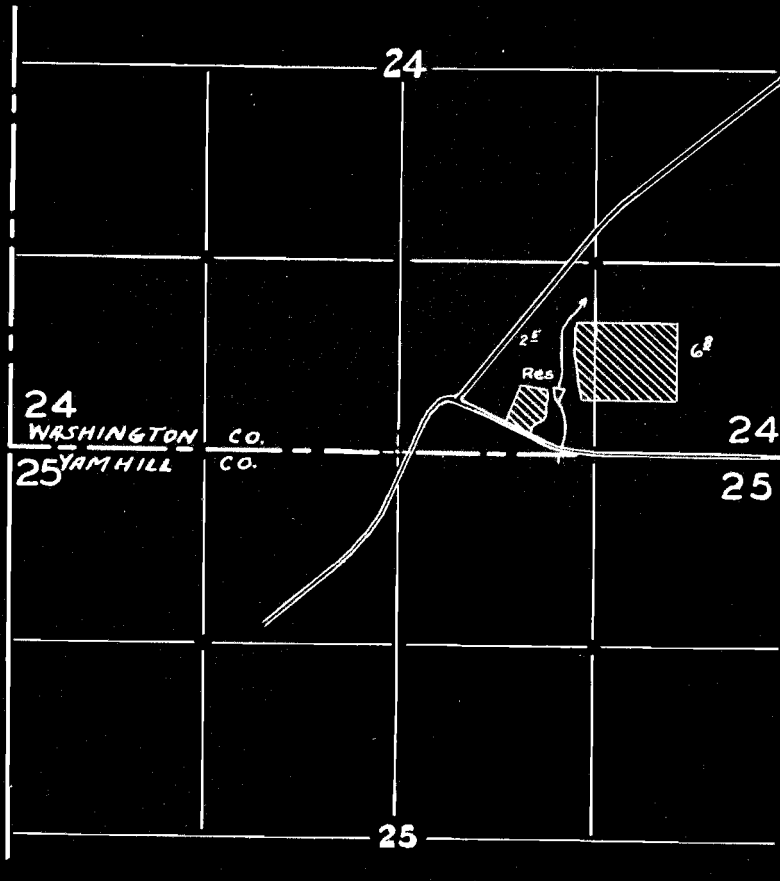

FINAL PROOF SURVEY

UNDER

R-27792

R-1446

Application No. 27843 Permit No. 21897

IN NAME OF

WINIFRED ORNDUFF

Surveyed 5-2-1956, by R.H. WHITBY