


T. 35 S., R. 2 W., W.M.

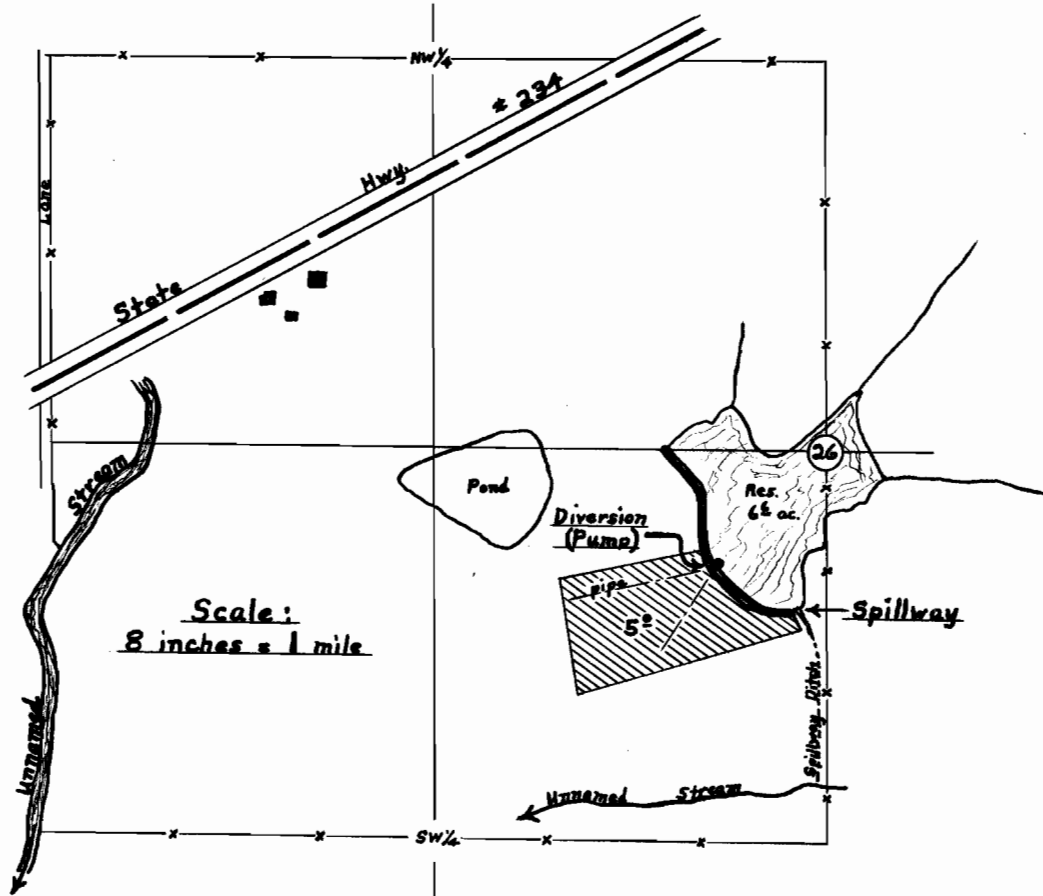

FINAL PROOF SURVEY

UNDER

27808

22348

Application No. R-27807 Permit No. R-1500

IN NAME OF

W.M. Quackenbush

Surveyed Jan. 30, 1957, by D.C. Hendrix, W.M.