


T. 23 S. R. 5 W. W.M.

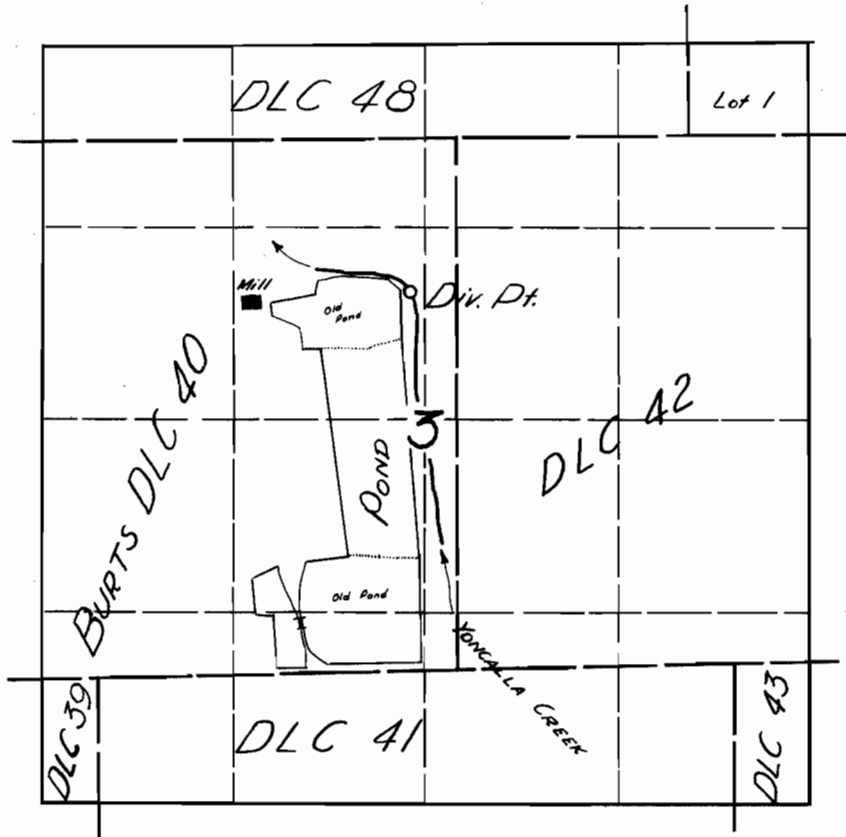

FINAL PROOF SURVEY

UNDER

R-29470

R-1673

Application No. 29546 Permit No. 23213

IN NAME OF

YONCALLA LBR. CO.

Surveyed 24 Sept 1956, by

C. Whitby