


T.6N.R.35E.W.M.

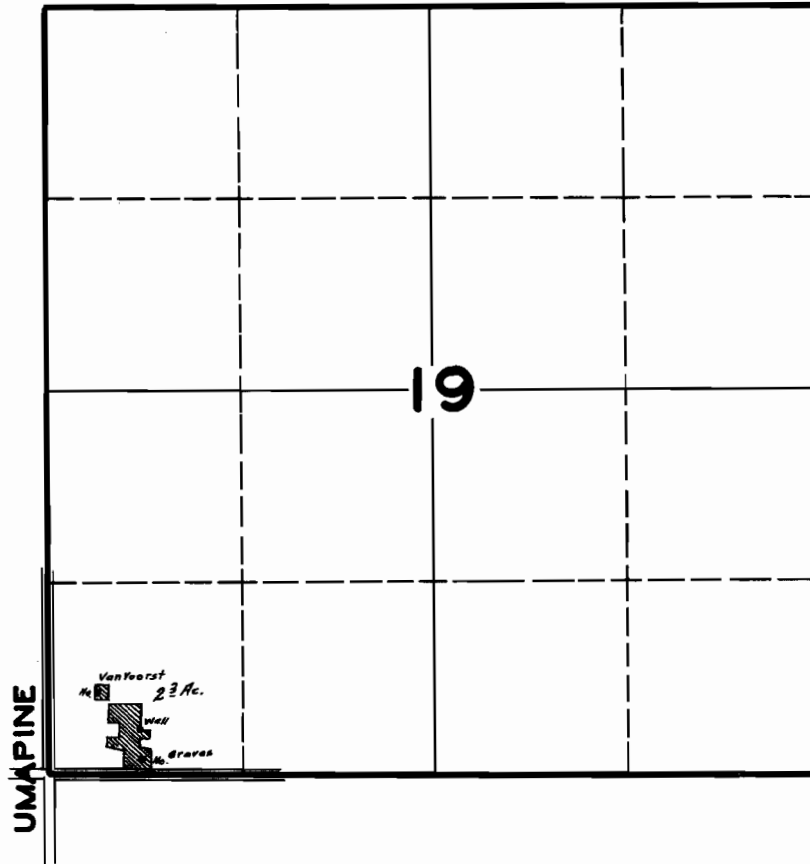

FINAL PROOF SURVEY
UNDER

Application No. U-139 Permit No. U-132

IN NAME OF

MABEL E. GRAVES & ISABEL VAN VOORST

Surveyed APR. 17, 1946, by *[Signature]*