


U-205
198
22838

T.33S, R.17E.W.M.

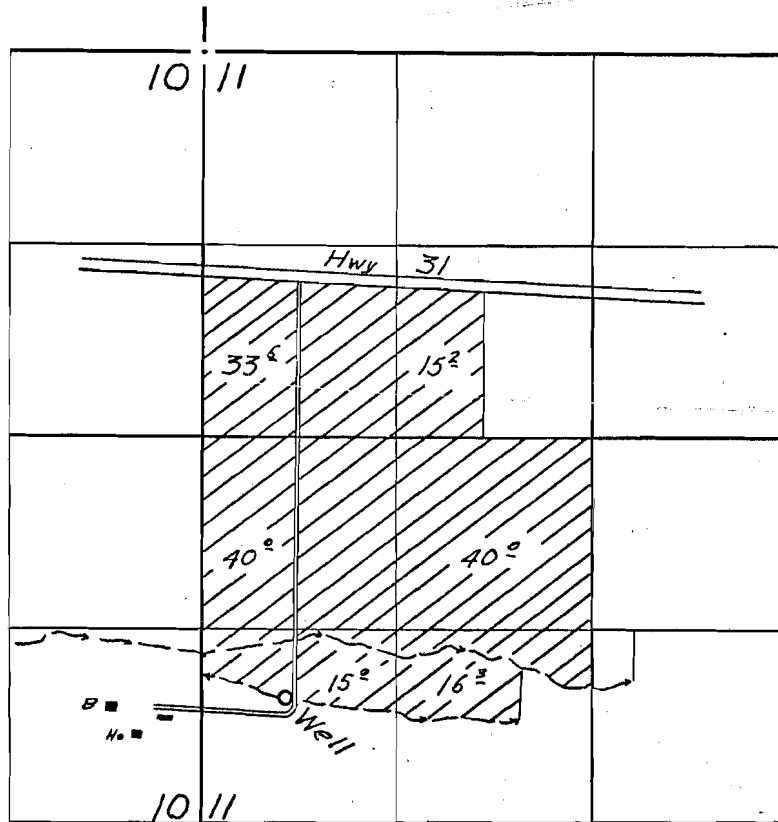

FINAL PROOF SURVEY
UNDER

Application No. U-205... Permit No. U-198...
IN NAME OF

JOHN V. WITHERS

Surveyed 8 October 1955, by Robert H. Reed