


# T.1N. R.13E. WM

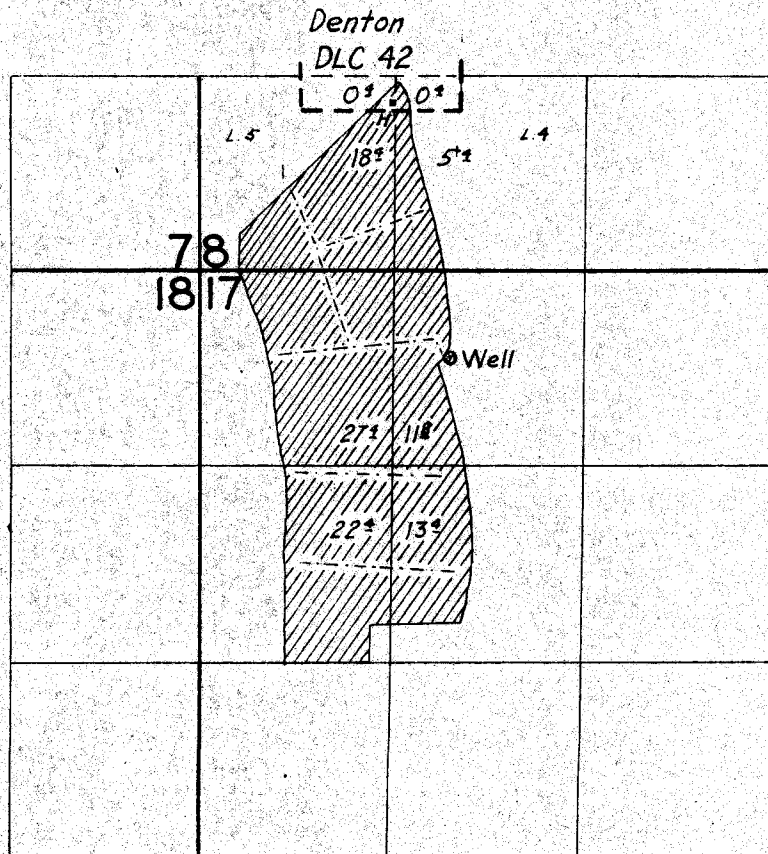

## FINAL PROOF SURVEY UNDER


IN NAME OF

C. S. Jones, Eva S. Jones, J. Stullman,  

Surveyed June 11 1911, by J. S. Jones