


T. I. S. R. 25 E. W. 1/4.

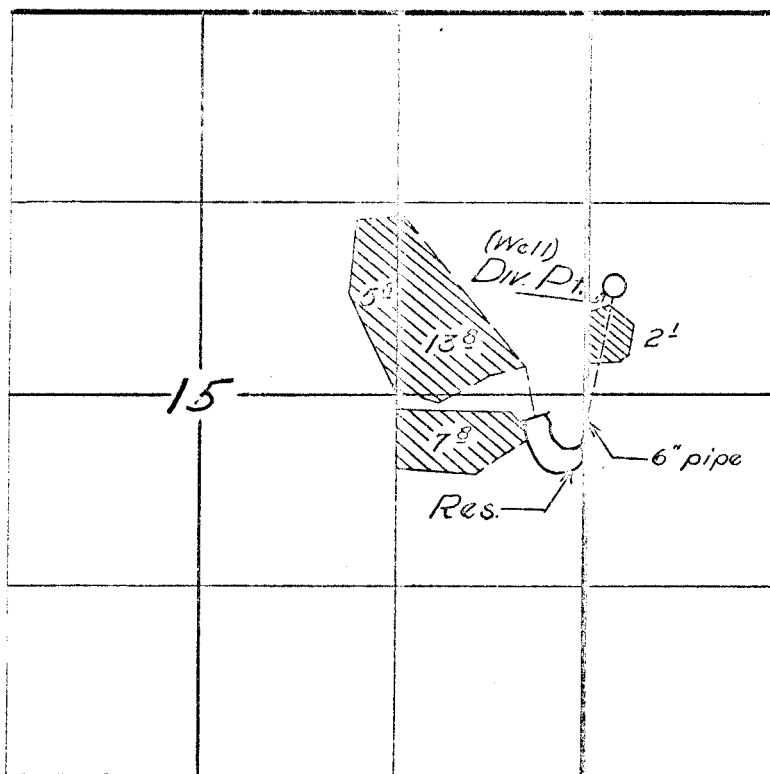

FINAL PROOF SURVEY

UNDER

Application No. U-243 Permit No. U-218

IN NAME OF

O. W. CUTSFORTHSurveyed 15 Apr. 1955, by T. JONES

1955-Z