


T18SR47EWM

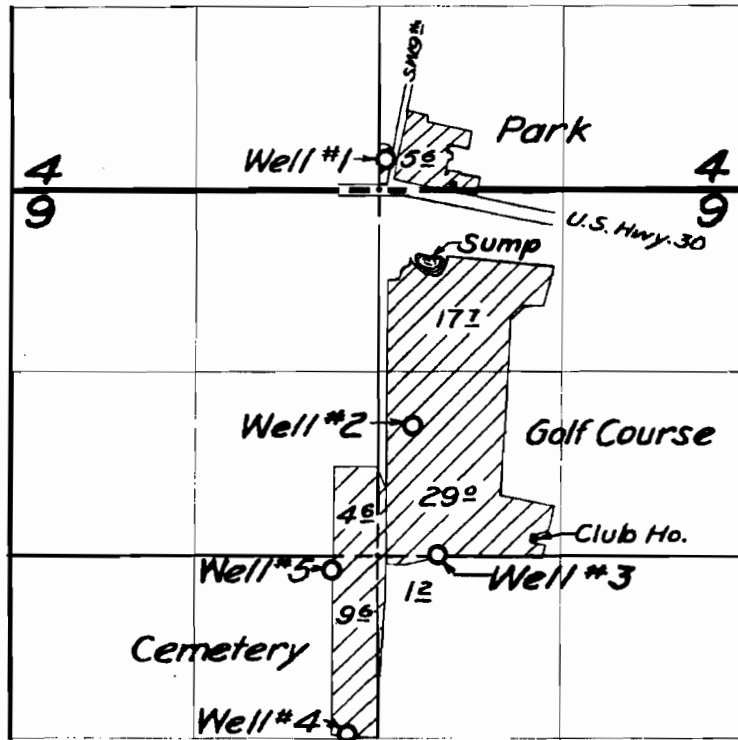

FINAL PROOF SURVEY

UNDER

Application No. U-473 Permit No. U-429
U-254 U-226


IN NAME OF

The City of Ontario

Surveyed Nov. 3 1955 by M. Besh

1955N

T18SR47EWM

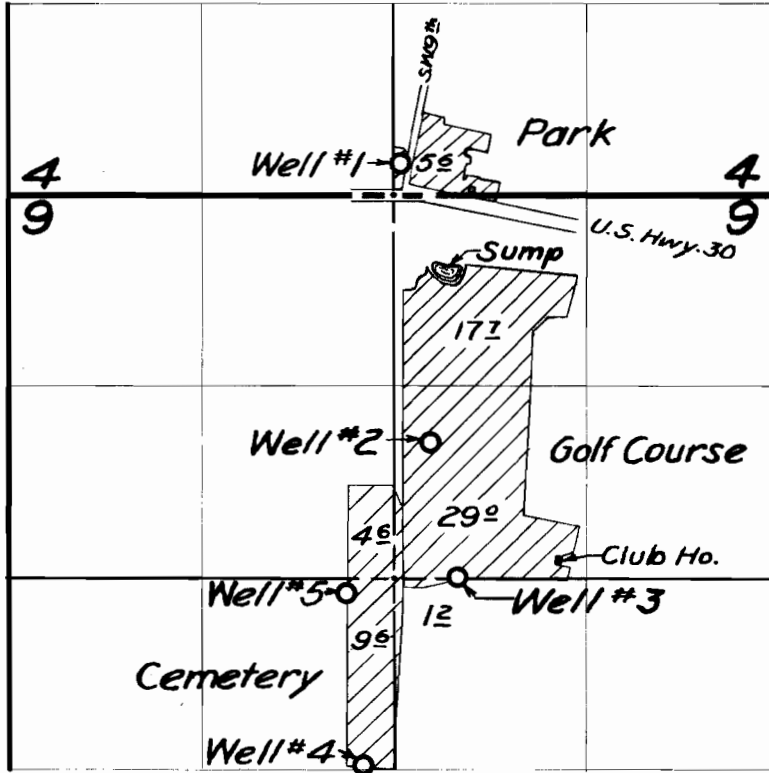

FINAL PROOF SURVEY

UNDER

Application No. U-473 U-254 Permit No. U-429 U-226

IN NAME OF

The City of Ontario

Surveyed Nov. 3 1955 by M. Besh