


SECTION

- 27
- 28
- 33
- 34

22845

TOWNSHIP 39 S., RANGE 10 E., W. M.

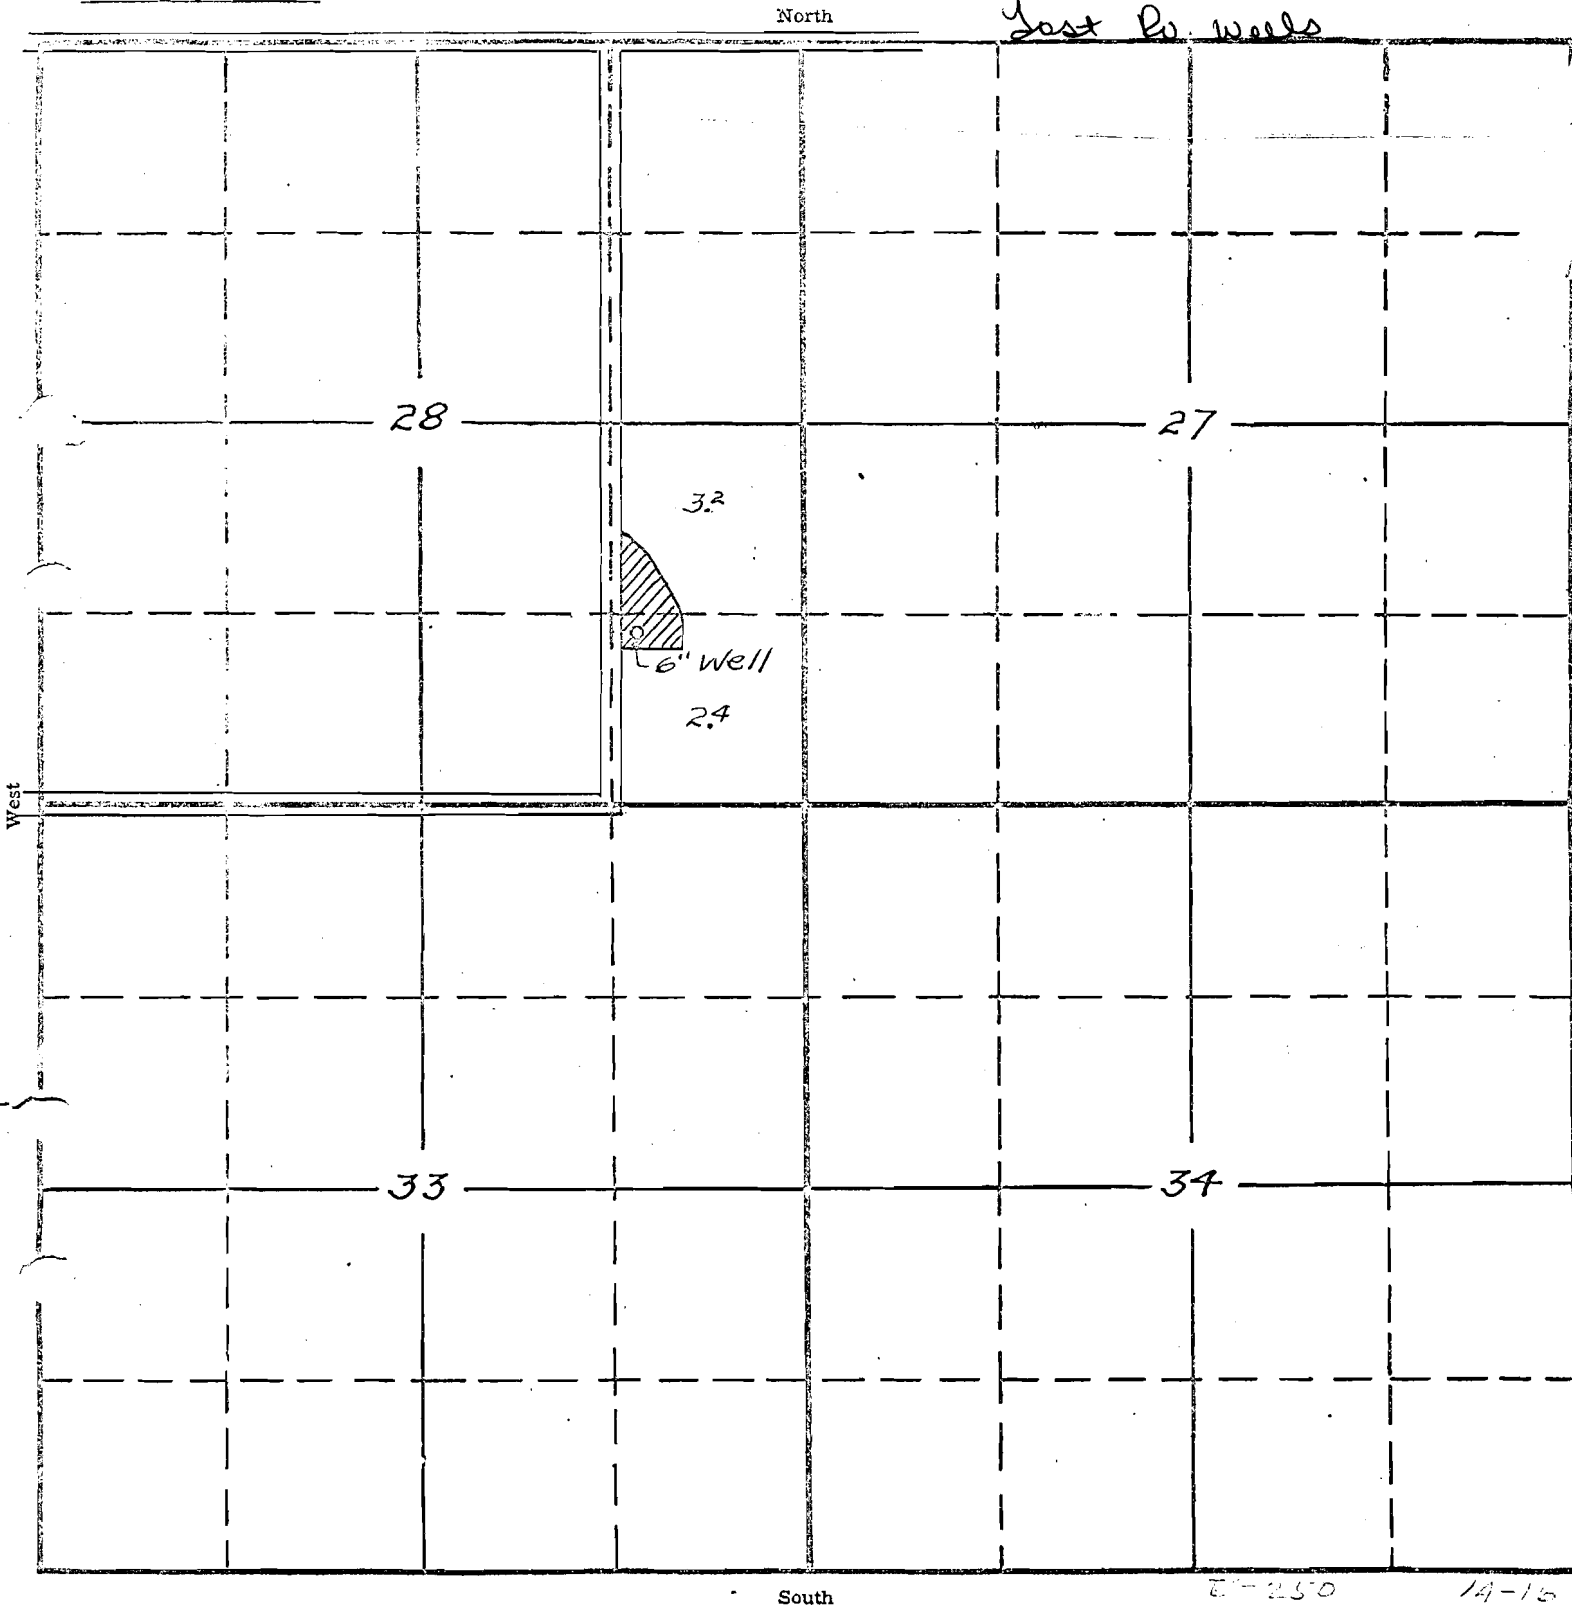

APPLICATION No. U-250
PERMIT No. U-

Glenn Dehlinger,
Klamath Falls, Oregon.