


T. 6 N. R. 36 E. W. M.

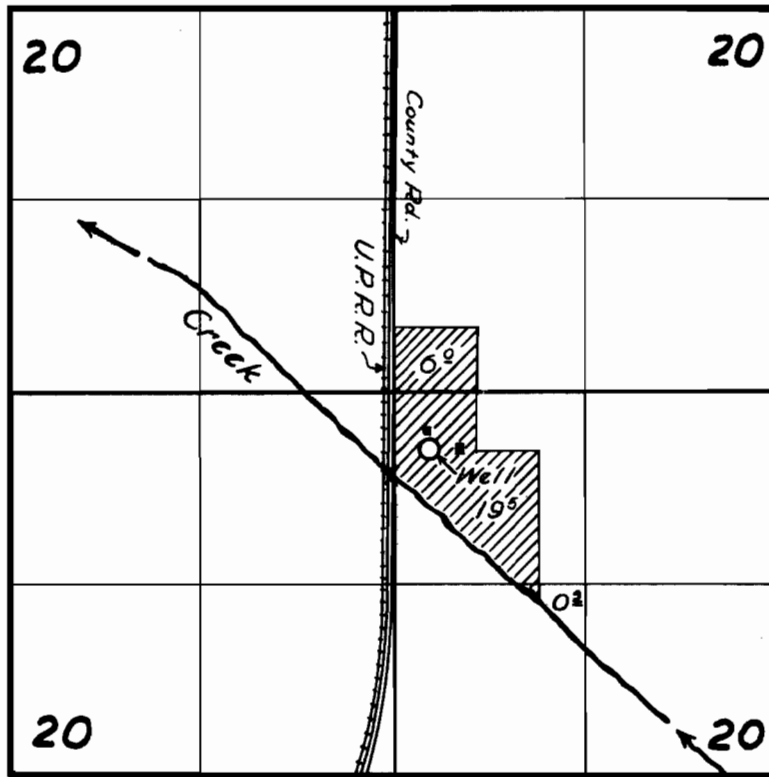

**FINAL PROOF SURVEY**

UNDER

Application No. U-277 Permit No. U-248

IN NAME OF

W. H. TILL

Surveyed 6 Nov. 1955, by

*W. H. Whiteby*

NZ-5F-65