


T.37S, R. 10E. W.M.

Swan Lake wells

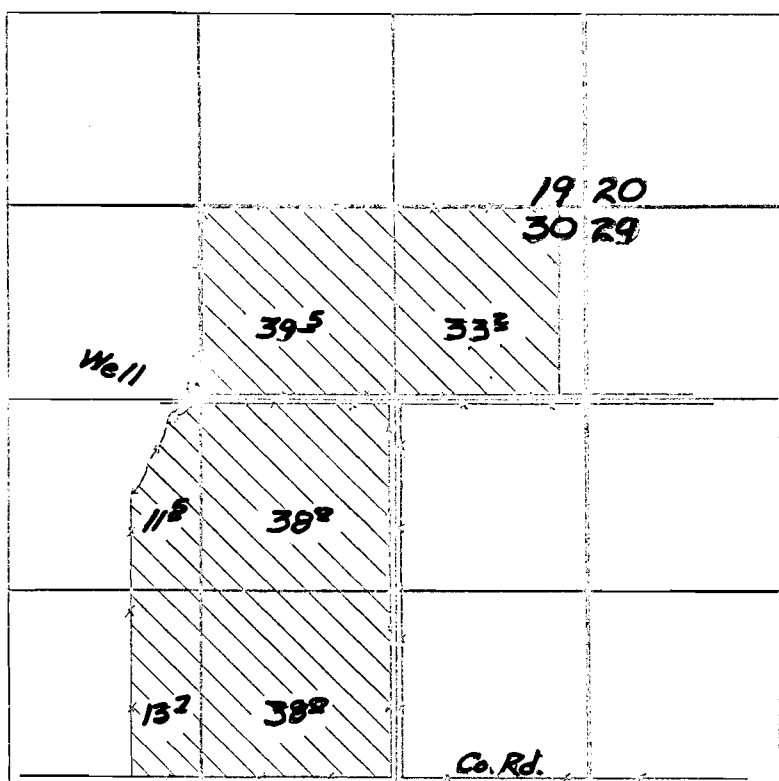

FINAL PROOF SURVEY
UNDER

Application No. U-279.. Permit No. U-250..
IN NAME OF

C. FRED COLLMAN

Surveyed 18 May. 1955, by H.L. Coffman