


T.38S, R.11 & 11 1/2 E. W.D.V.

Buck Ck: Yoma Valley well

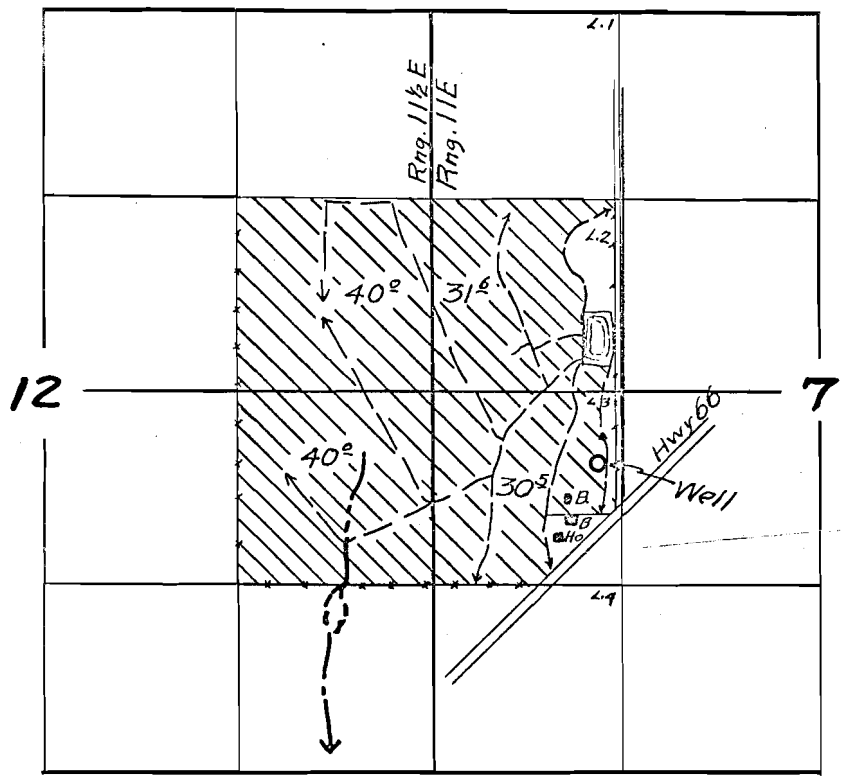

**FINAL PROOF SURVEY**

UNDER

Application No. U-286 Permit No. U-260  
IN NAME OF

LOUIS TOFELL

Surveyed 14 May 1955, by H.L. Coffman.