


T.5N., R.28E., W.M.

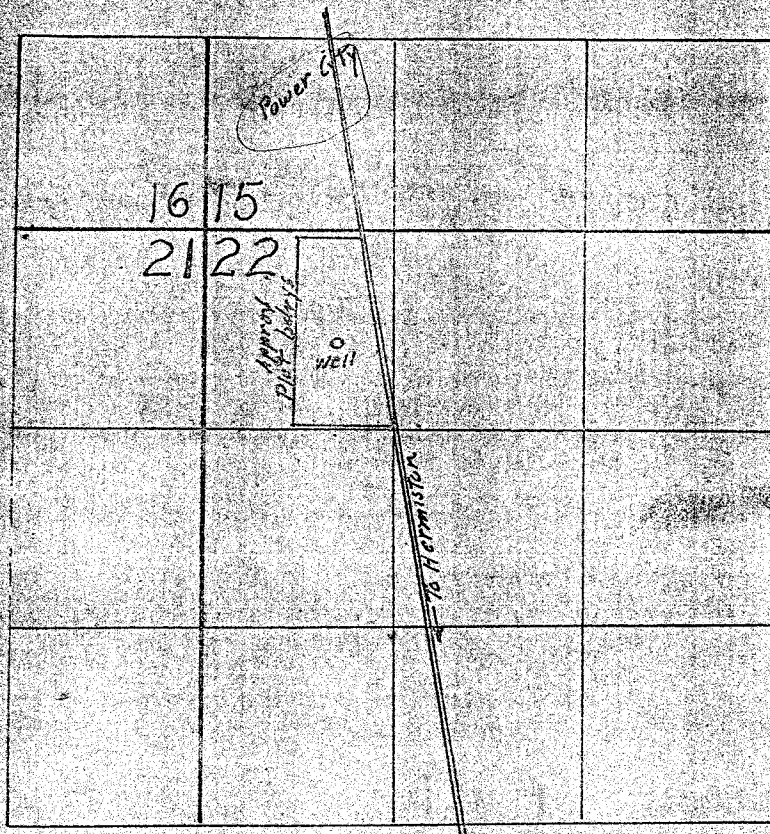

Application No. U-290 Permit No. U-264