


T.38S, R.11 1/2 E.W.M.

Bucke Ck! Yuma Valley wells

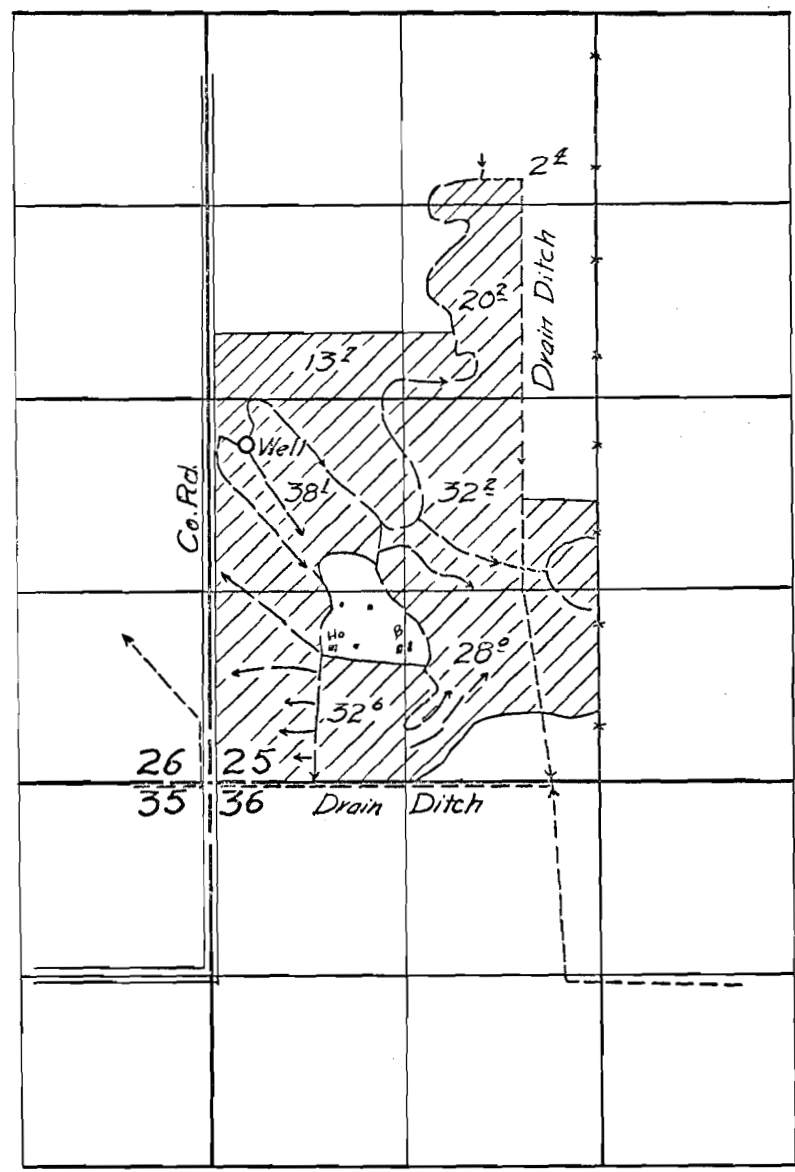

FINAL PROOF SURVEY
UNDER

Application No. U:316..... Permit No. U:290.....
IN NAME OF

RICHARD HOEFLER

Surveyed 16 May.... 1955, by H.L. Coffman.....