


T. 2 N., R. 32 E., W.M.

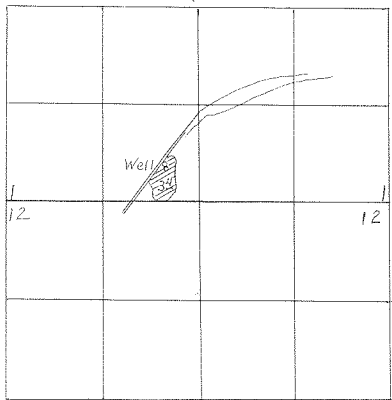

SECTION 12, T. 2 N., R. 32 E., W.M.