


U-297
C-22853

T. 6N. R. 35 & 36 E. W.M.

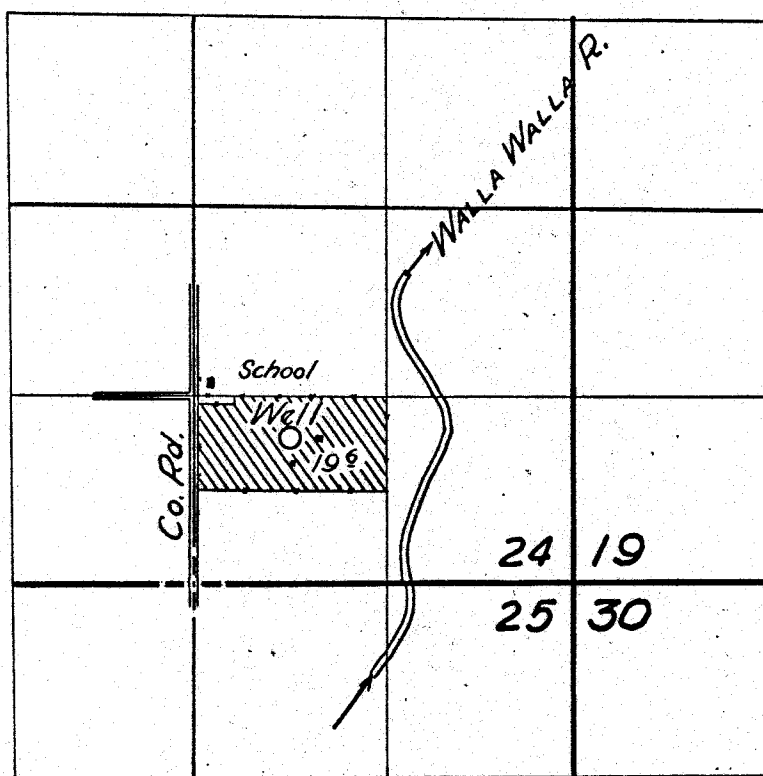

FINAL PROOF SURVEY
UNDER

Application No. U-322 Permit No. U-297
IN NAME OF

JOHN E. POTTS, M.D.

Surveyed 4 Nov. 1955, by [Signature]

NZ-5F-102