


T.38S., R.10E.W.M.

Swan Lake wells

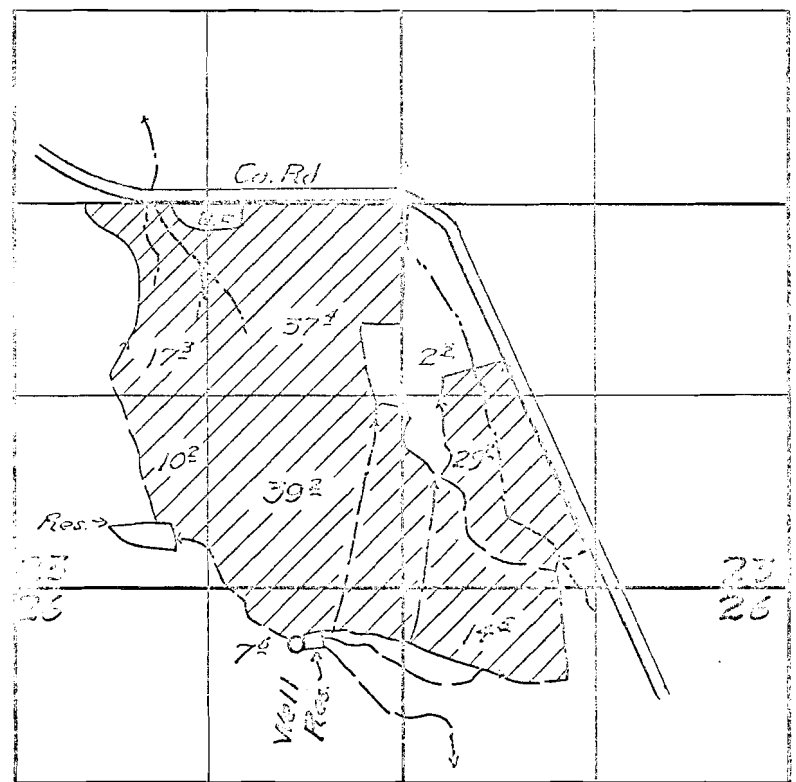

UNDER

Application No. U-323 Permit No. U-200
IN NAME OF

MAUDE E. LISKEY

Surveyed 10 May 1955, by M.L. Cochran