


T. 9S. R. 40E. WM.

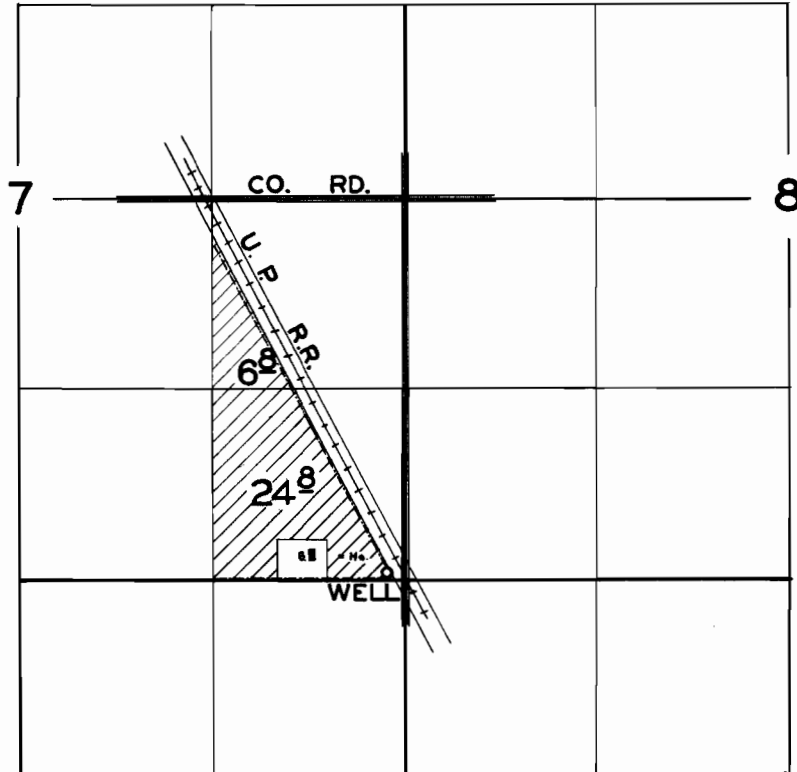

FINAL PROOF SURVEY

UNDER

Application No. U-325 Permit No. U-300

IN NAME OF

A. S. BOYD

Surveyed 22 MAY 1956, by M. BISH

BBB-4N-88

22855