


T.39S, R.9 & 10E.W.M.

Klamath River wells

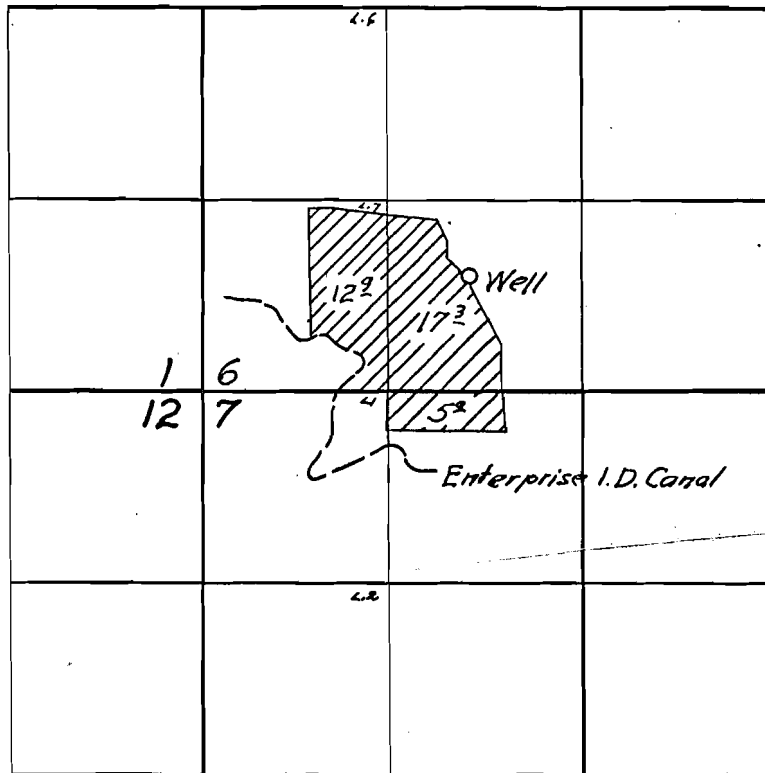

**FINAL PROOF SURVEY**  
UNDER

Application No. U-329 Permit No. U-303  
IN NAME OF

GEORGE M. WHEELER

Surveyed 19 May, 1955, by H.L. Coffman