


T.27S.R.15E.W.M.

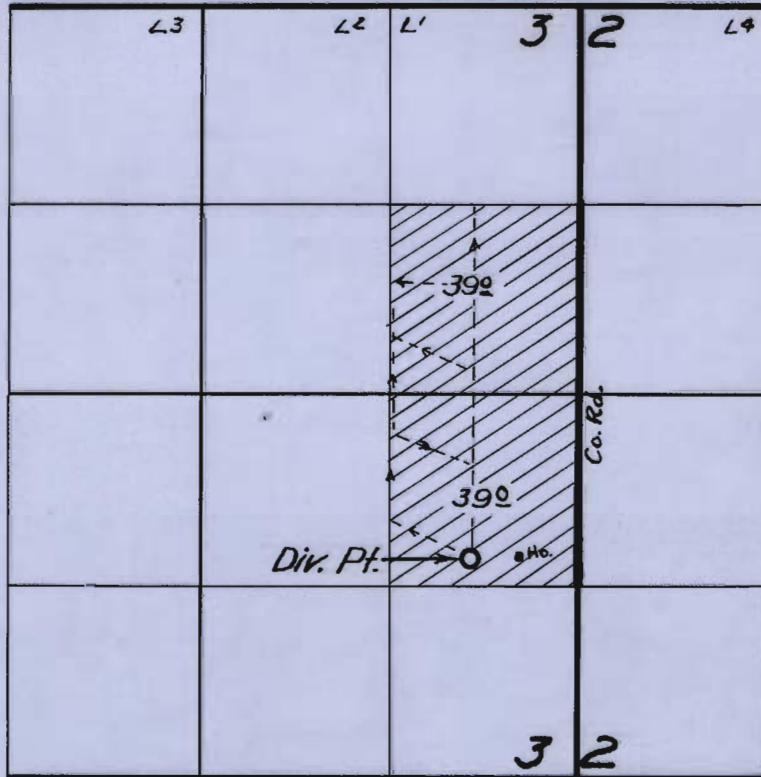

FINAL PROOF SURVEY
UNDER

Application No. U-347 Permit No. U-322
IN NAME OF

Leonard Pitcher

Surveyed June 20 1955, by T. Jones

CHZ-45K-115