


T.5&amp;6N.R.35E.W.M.

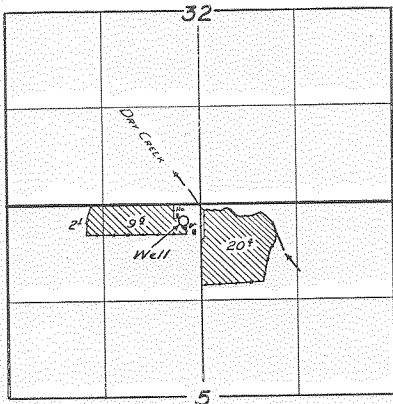

## FINAL PROOF SURVEY

UNDER

Application No. U-348 Permit No. U-323

IN NAME OF

NELL M. MURRAYSurveyed 10 Nov. 1955, by [Signature]