


T.39 S., R. 19 & 20 E.W.M.

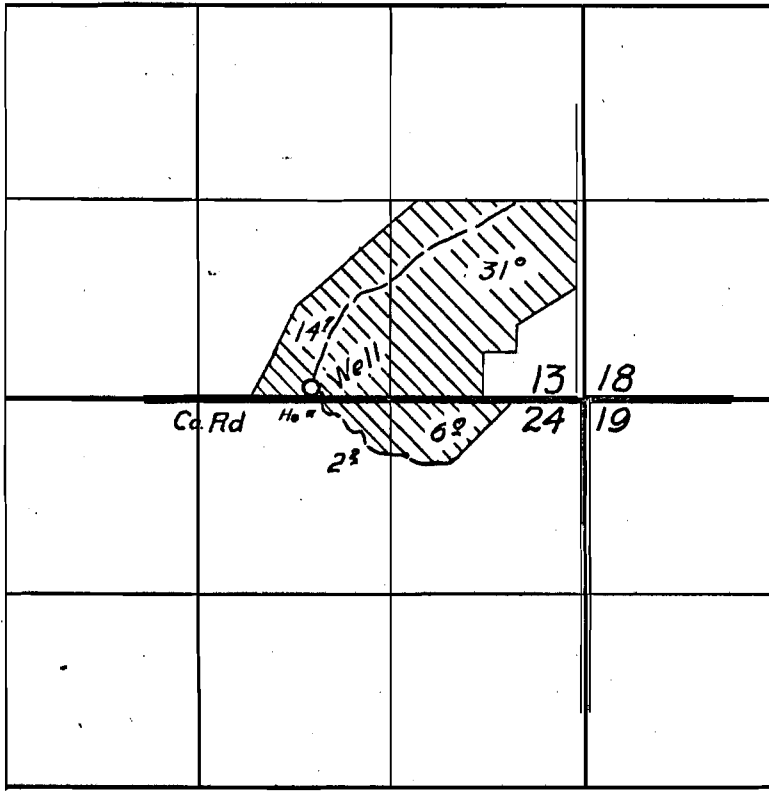

FINAL PROOF SURVEY
 UNDER

Application No. U-355 Permit No. U-330
 IN NAME OF

ELMO M. ANGELE

Surveyed 18 June 1955, by T. Jones