


T.15 S.R.43 E.W.M.

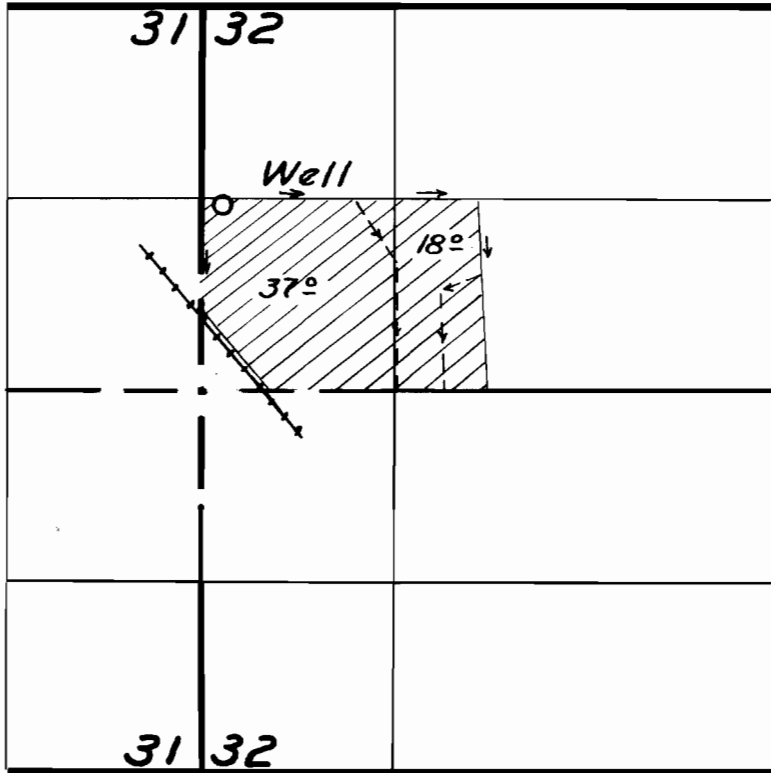

FINAL PROOF SURVEY

UNDER

Application No. U-369 Permit No. U-338

IN NAME OF

HIDEO HARADA

Surveyed Oct. 28 1955 by M. Bish

1955 N