


T.15 S.R.43 E.W.M.

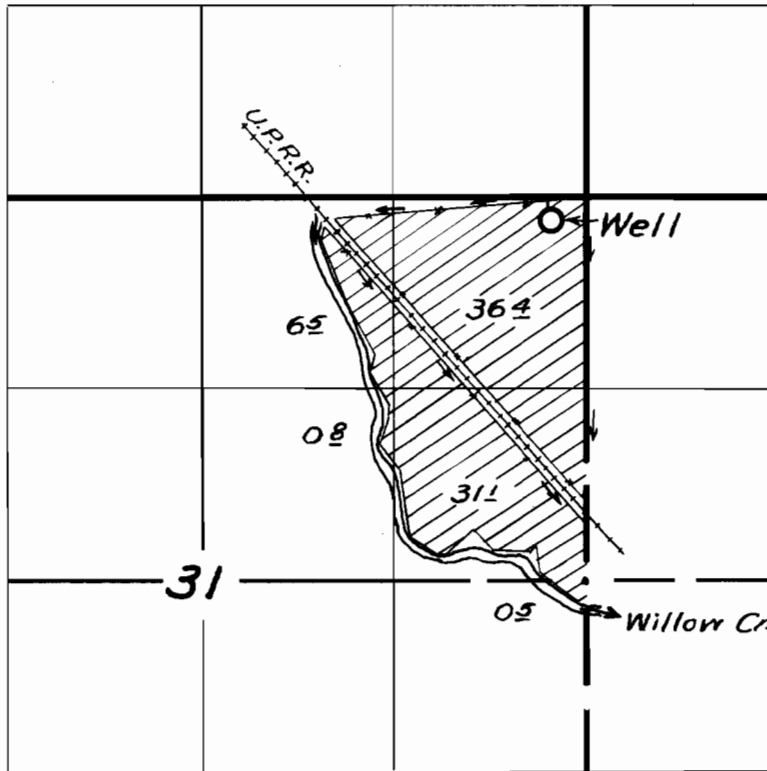

**FINAL PROOF SURVEY**

UNDER

Application No. U-350 Permit No. U-344

IN NAME OF

Eugene D. Smith

Surveyed Oct. 27, 1955, by M. Bish