


T. 5 & 6 N. R. 35 E. W.M.

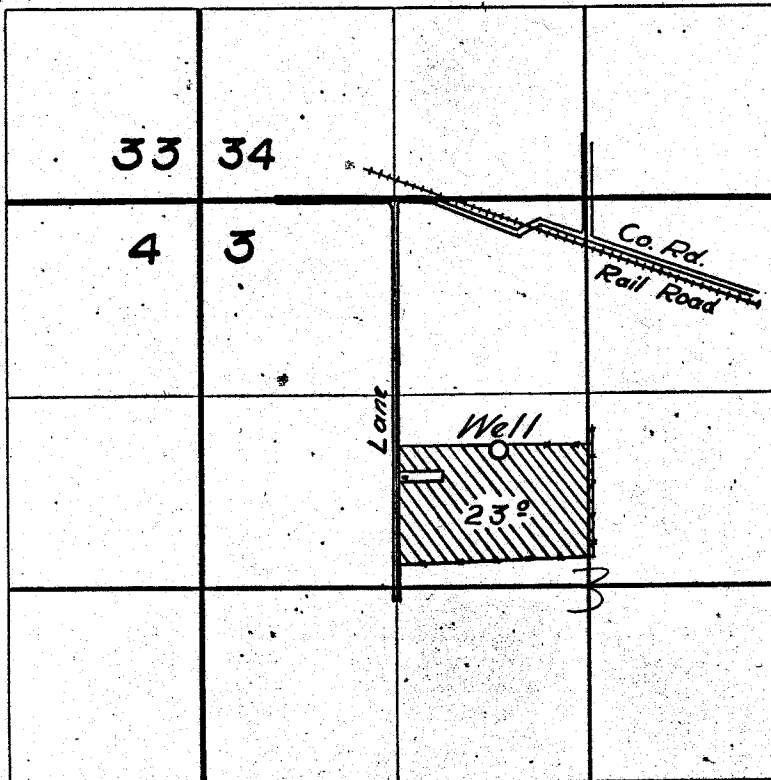

FINAL PROOF SURVEY

UNDER

Application No. U-401 Permit No. U-365

IN NAME OF

P. S. GIBBONS, JR.

Surveyed 10 Nov. 1955, by [Signature]