


T14SR39EWM

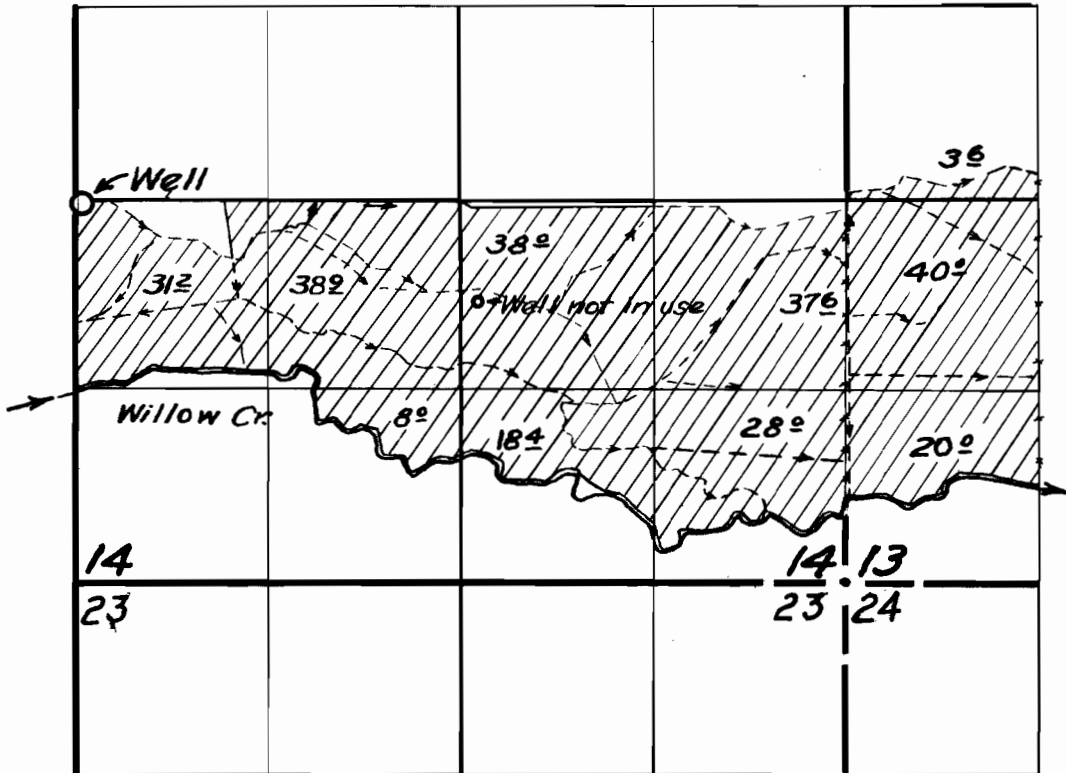

FINAL PROOF SURVEY

UNDER

Application No. U-385 Permit No. U-367

IN NAME OF

Ernest & Fred Locey

Surveyed Nov. 1 & 2 1955, by Tm. Bish