


T.15 S. R. 4 2 E.W.M.

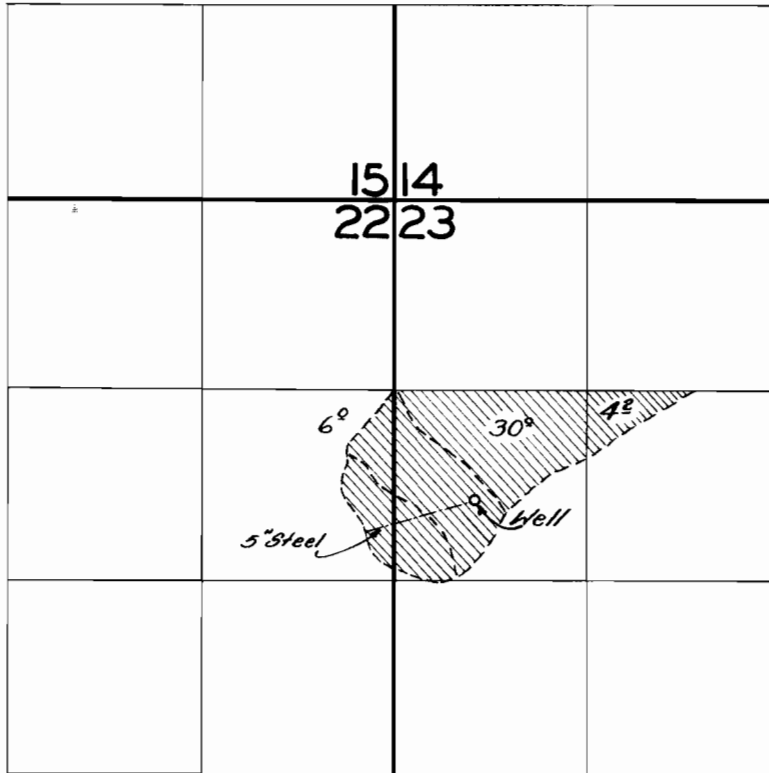

FINAL PROOF SURVEY

UNDER

Application No. U-404 Permit No. U-374

IN NAME OF

Ralph T. Hawk

Surveyed Sept. 18 1956, by C. O. Bartels

BBC-9N-128