


T.38S., R.11E.W.W.

Bude Cr. & Yuma Valley Weeds

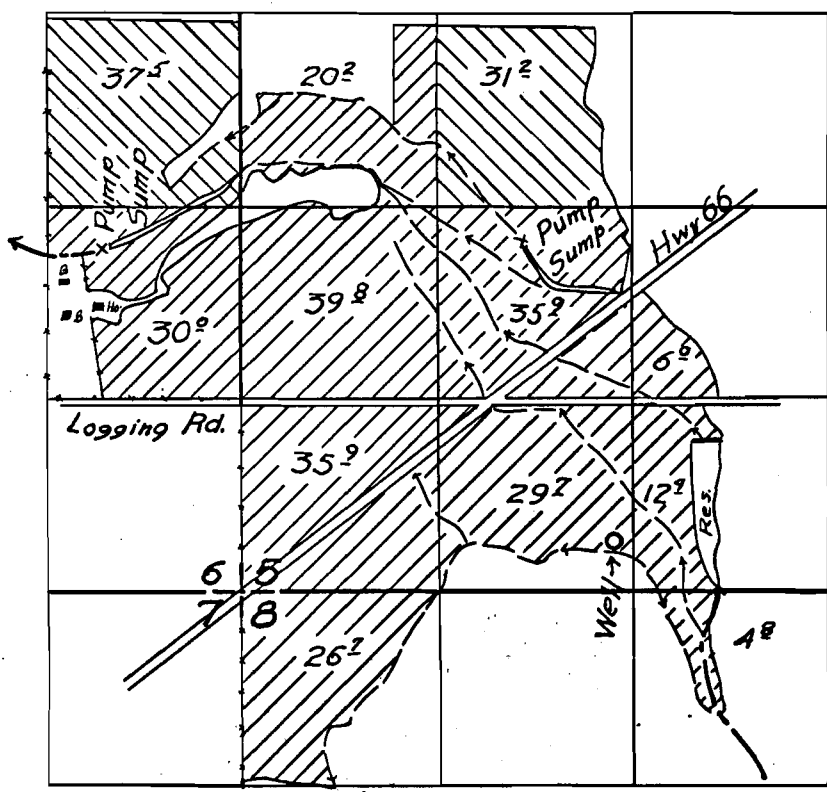

FINAL PROOF SURVEY

UNDER

U-269

U-238



Application No. U-407

Permit No. U-377



IN NAME OF

LEONARD G. RITTER

Surveyed 14 May... 1955., by H.L. Coffman.