


T.16 S.R.43E.W.M.

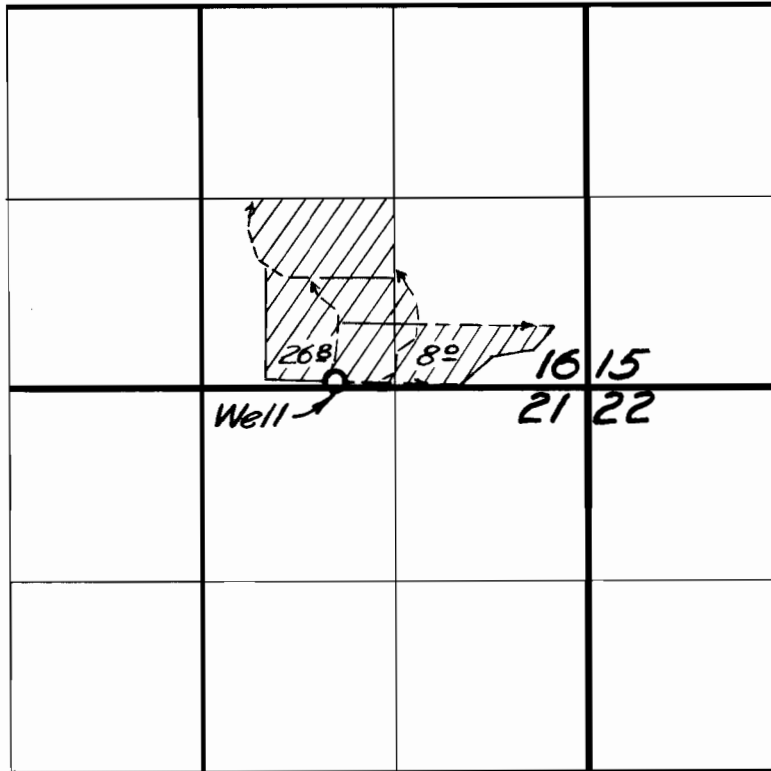

FINAL PROOF SURVEY

UNDER

Application No. U-414 Permit No. U-382

IN NAME OF

Ralph E. Altig

Surveyed Oct. 26 1955, by m. Beh