


T.15&16 S., R.43 E. W.M.

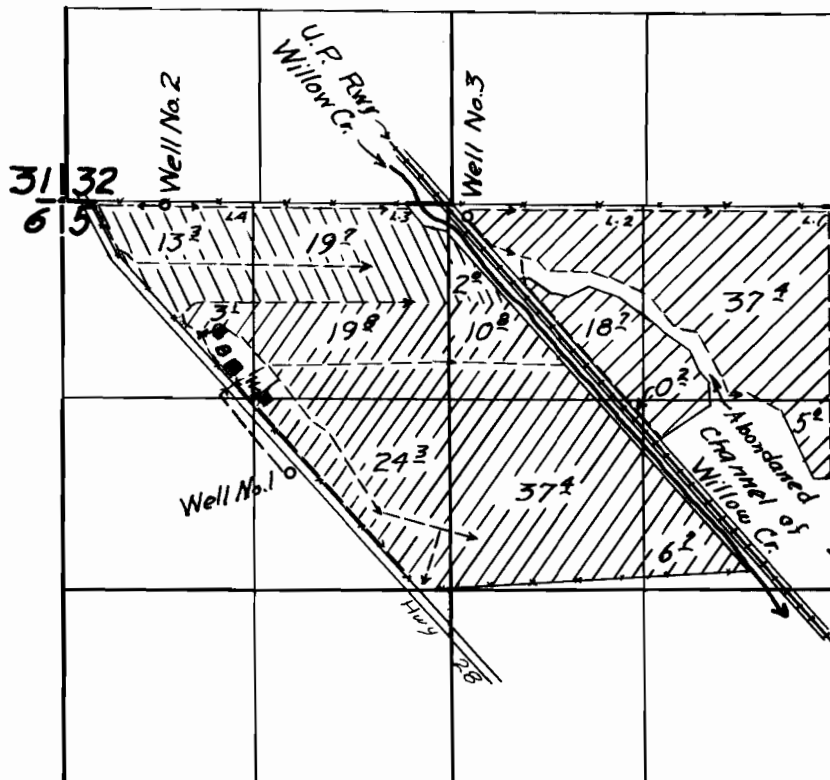

### FINAL PROOF SURVEY

UNDER

U-382, U-383 &

Application No. U-384... Permit No. U-386....

IN NAME OF

F.W. CAMMANN

Surveyed 31 March 1955, by H.L. Coffman....