


T.38S, R.11½E, W.M.

Bucke Ck. & Gunna Valley Wells

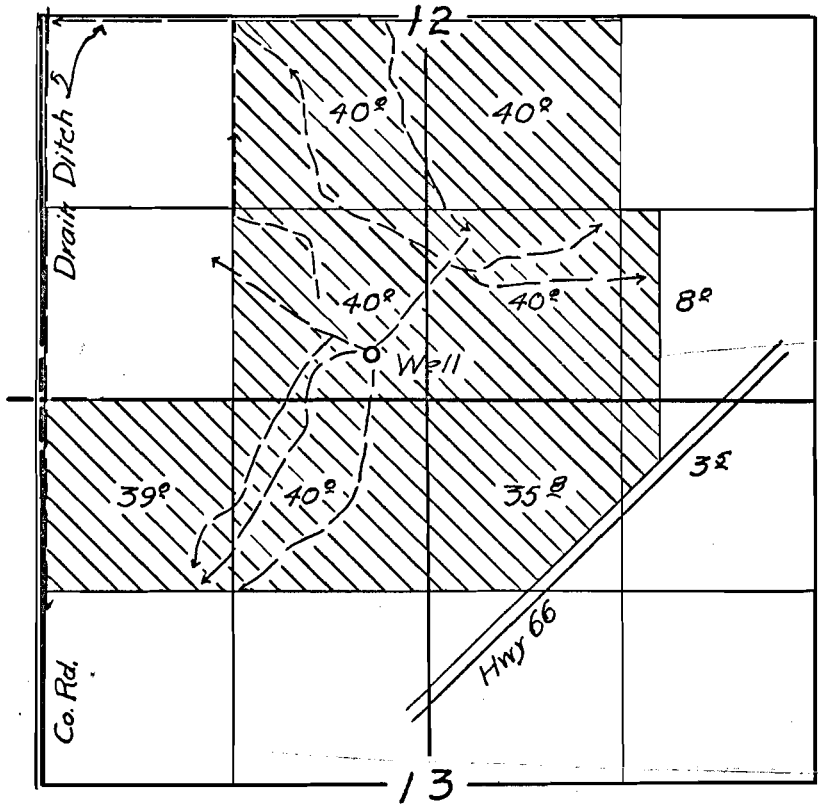

FINAL PROOF SURVEY
UNDER

Application No. U-446 Permit No. U-401
IN NAME OF

F. M. CHALLIS

Surveyed 16 May 1955, by H. L. Coffman