


T.15 S.R.42 E.W.M.

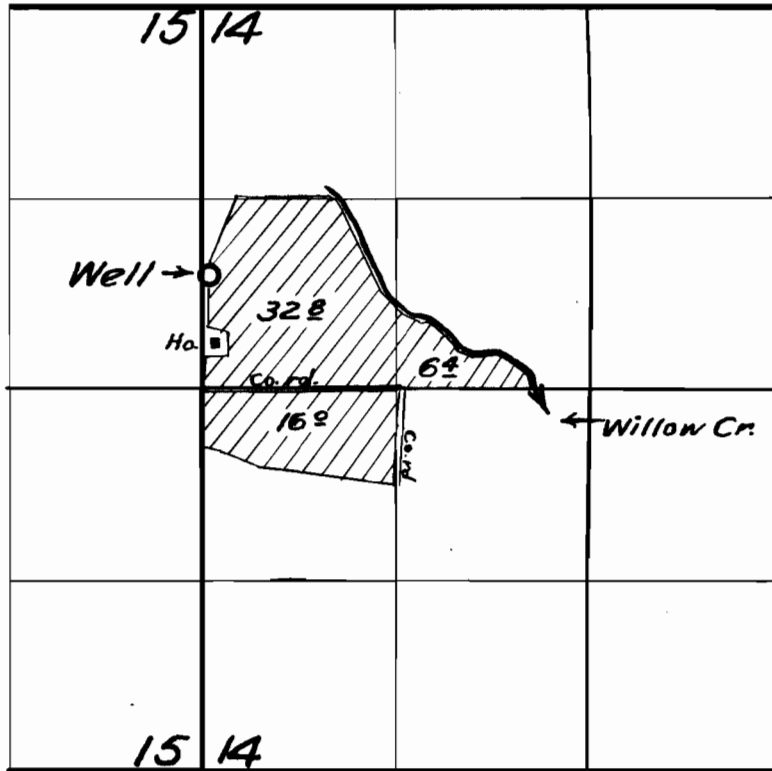

FINAL PROOF SURVEY

UNDER

Application No. U-437 Permit No. U-408

IN NAME OF

ARTHUR ANTRIM.

Surveyed Oct. 29 1955, by M. Beh

1955 N