


T.40S.R.20E.W.M.

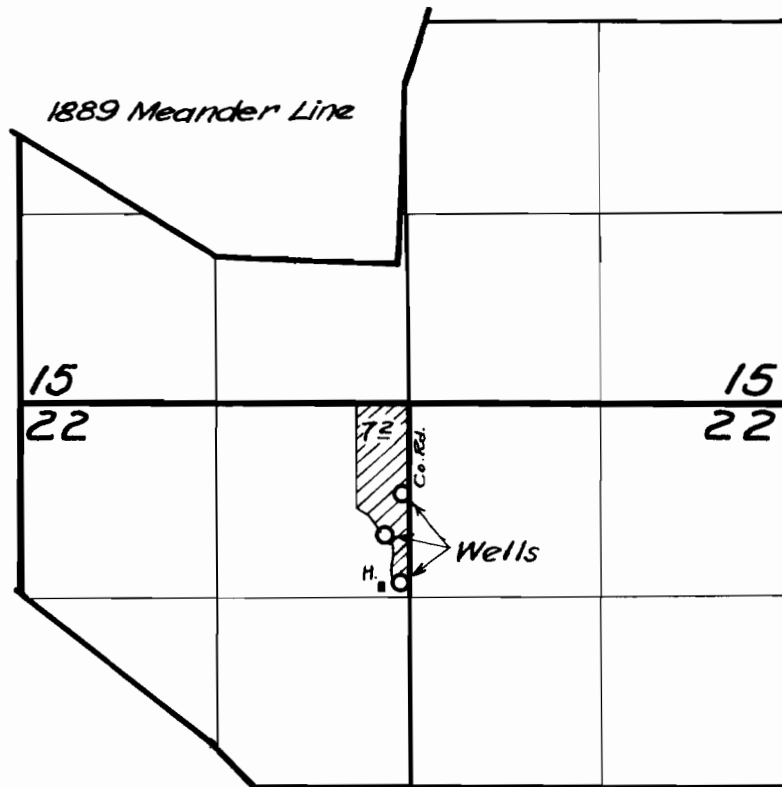

FINAL PROOF SURVEY
UNDER

Application No. U-527 Permit No. U-478
IN NAME OF

Norman & Alice Wells

Surveyed June 17, 1955, by T. Jones

CHZ-38K-146