


T. 1N. R. 12 & 13 E. WM

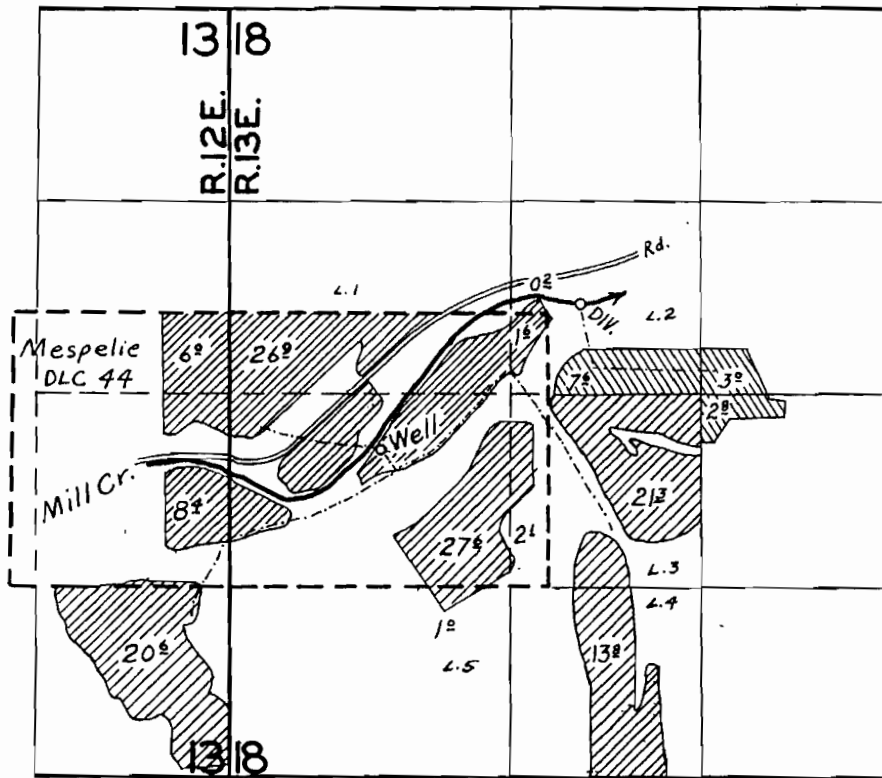

FINAL PROOF SURVEY

UNDER

Application No. 25000 Permit No. 1-780

IN NAME OF

Bruce T. Hull

The Pines (Ladys L. Loggers.)

Surveyed June 10 19 51, by T. Jones

T 10218