


T. 3 N., R. 34 E., W.M.

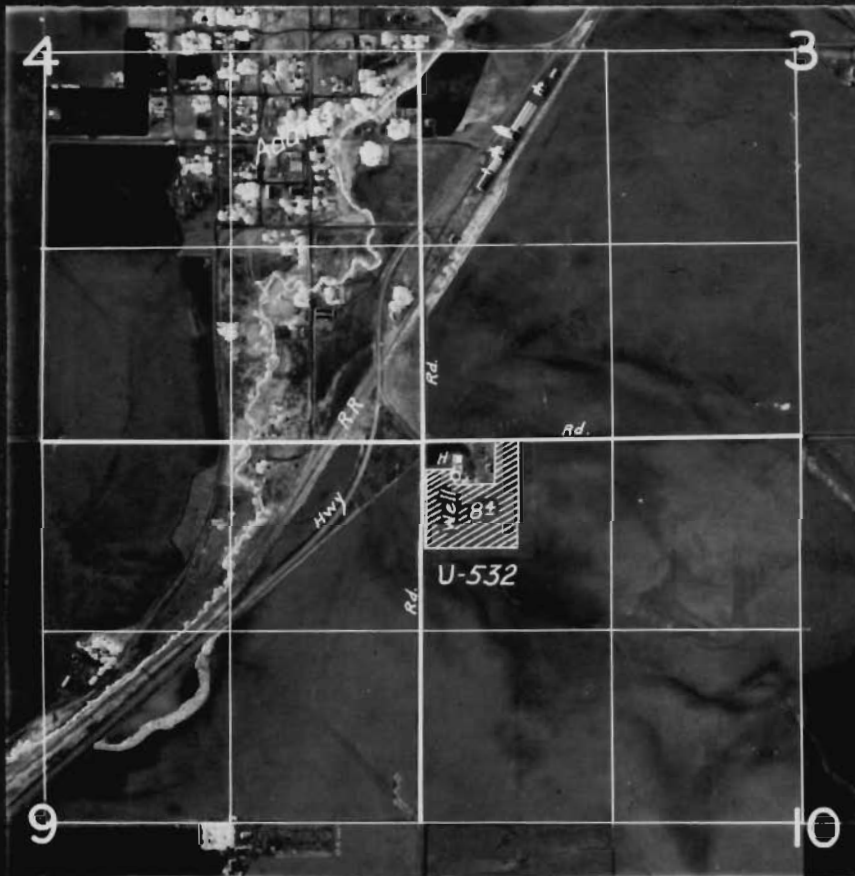

**FINAL PROOF SURVEY**  
UNDER

Application No. U-532 Permit No. U-483  
IN NAME OF

William R. Coppock

Surveyed May 17, 1954, by T. Jones

NZ-11E-56