


T. 36 N. R. 34 E. W. M.

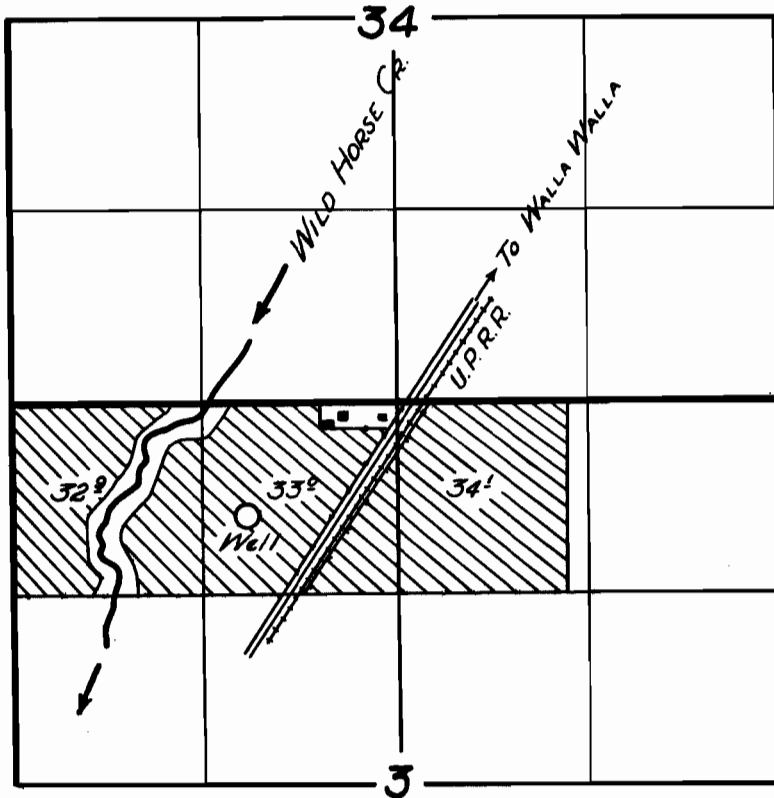

**FINAL PROOF SURVEY**

UNDER

Application No. U-568 Permit No. U-520

IN NAME OF

***BERKELEY A. DAVIS***

Surveyed 7 Nov. 1955, by *D. Whiteby*