


T. 6N. R. 35E. W. M.

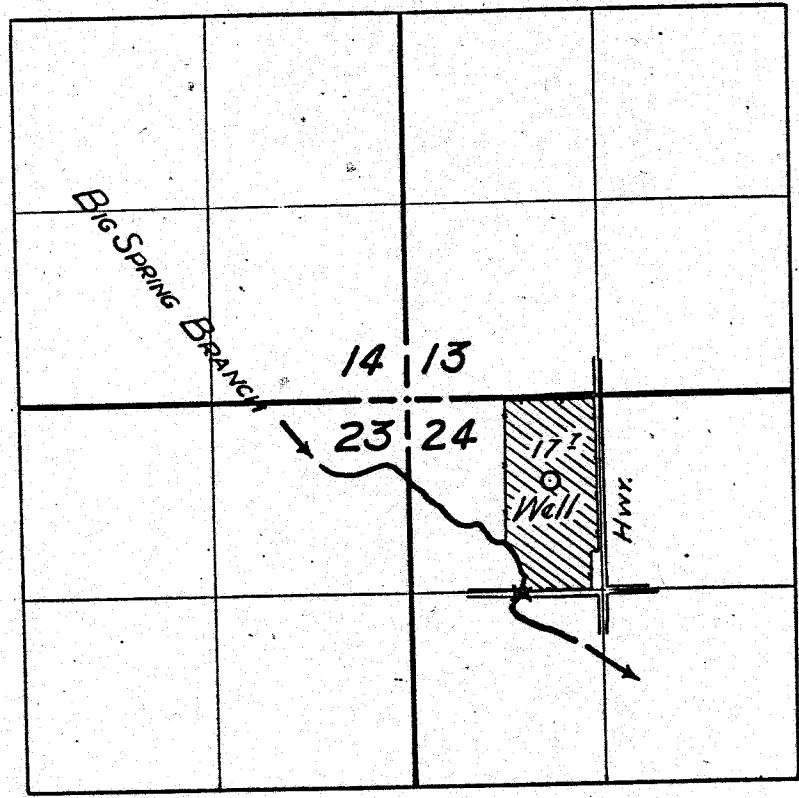

FINAL PROOF SURVEY
UNDER

Application No. U-605 Permit No. U-539
IN NAME OF

E. F. ARNOLD

Surveyed 5 Nov. 1955, by [Signature]