


T.2N.R.20E.W.M.

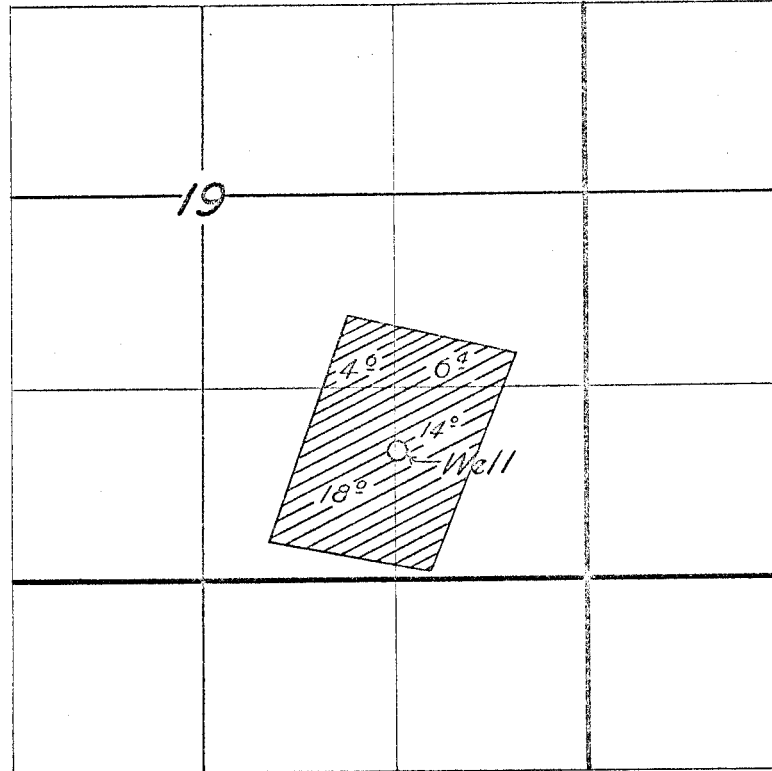

FINAL PROOF SURVEY
UNDER

Application No. U-541 Permit No. U-542
IN NAME OF

EARL P. & MYRA MAUDE HOAG

Surveyed 13 Apr. 1955, by T. JONES

1955-Z