


T. 1N. R. 12 & 13 E. WM

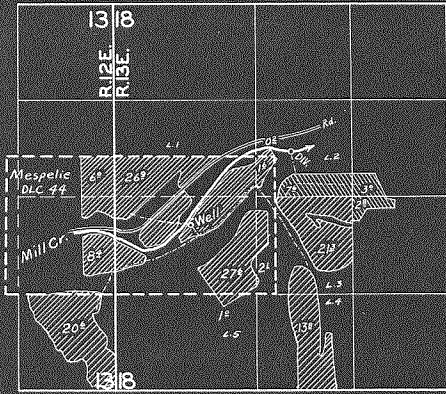

FINAL PROOF SURVEY

UNDER

Application No. 2590 Permit No. 100

IN NAME OF

James A. Miller (Successors)

Surveyed June 10 1902 by James A. Miller

