


T6N. R. 35E. W.M.

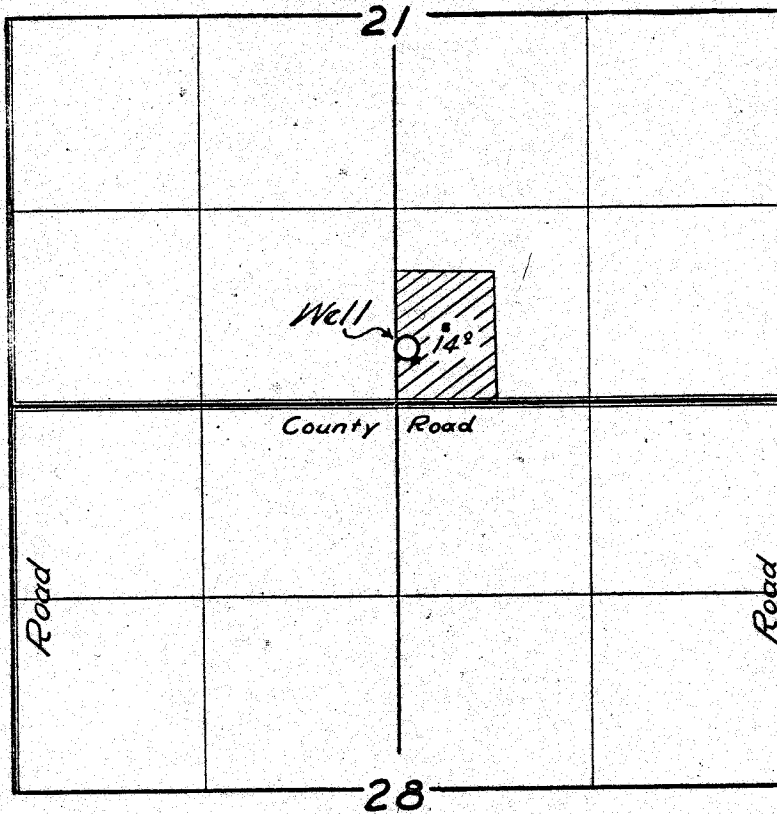

FINAL PROOF SURVEY
UNDER

Application No. U-648 Permit No. U-595

IN NAME OF

ORVAL BOWERS

Surveyed 8 Nov. 1955, by [Signature]