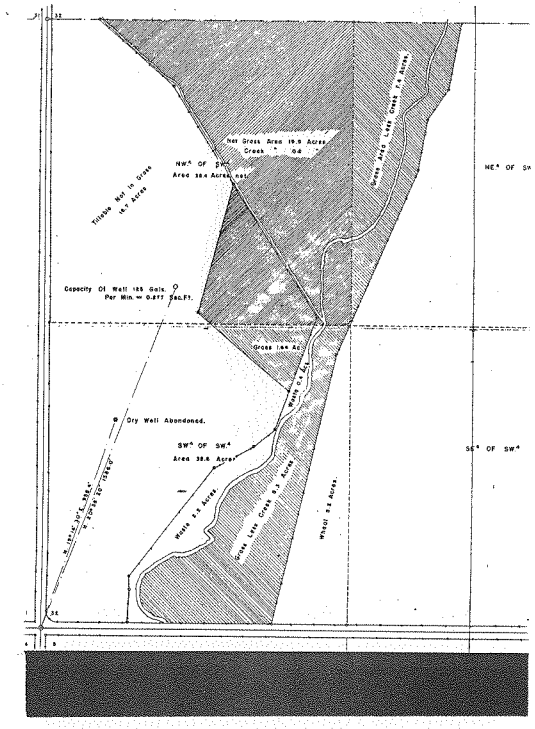

Center Sec. 32

U-620

I, B.Hayes, County Surveyor for Umatilla Coun
do hereby certify that this Map was made from notes t
during an Actual survey made by me on Septemper the
1933; that the bearing of the well is N. 26° 38' 20" E. and
1284.6 feet from the S.W. Corner of Section 32, Township 4, N
34, E.W.M.

COUNTY SURVEYOR.

PLAT OF SURVEY
FOR
L.L.ROGERS.
LOCATION OF DEEP WELL
AND LAND TO BE IRRIGATED.
LOCATED IN THE SW¼ OF SECTION 32
T. 4 N., R. 34 E.W.M.
Scale 1" = 200'

E. B. Hayes

Application No. 22897
Permit No.

DECEASED

E-620