


Hwy # 395

Flow

Kod Creek


312

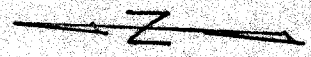

500' 26' E

U-621  
C-22898

Application No. U-688  
Permit No. U-621

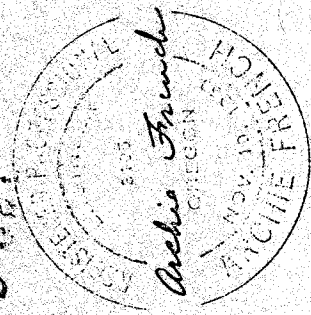

Tract owned by  
Henry Lembcke Jr.

260

Well location

Roadway

308

362.99  
M. 22.24 N

329.88

PROPOSED WELL LOCATION  
for Henry Lembcke Jr.  
owned by Archie French  
1/8/54. Scale 1" = 100'  
S.C. 28, T. 2 N, R. 2 E

RECEIVED  
APR 6 1958  
STATE ENGINEER  
SALEM, OREGON