



Range 26 E.W.M.

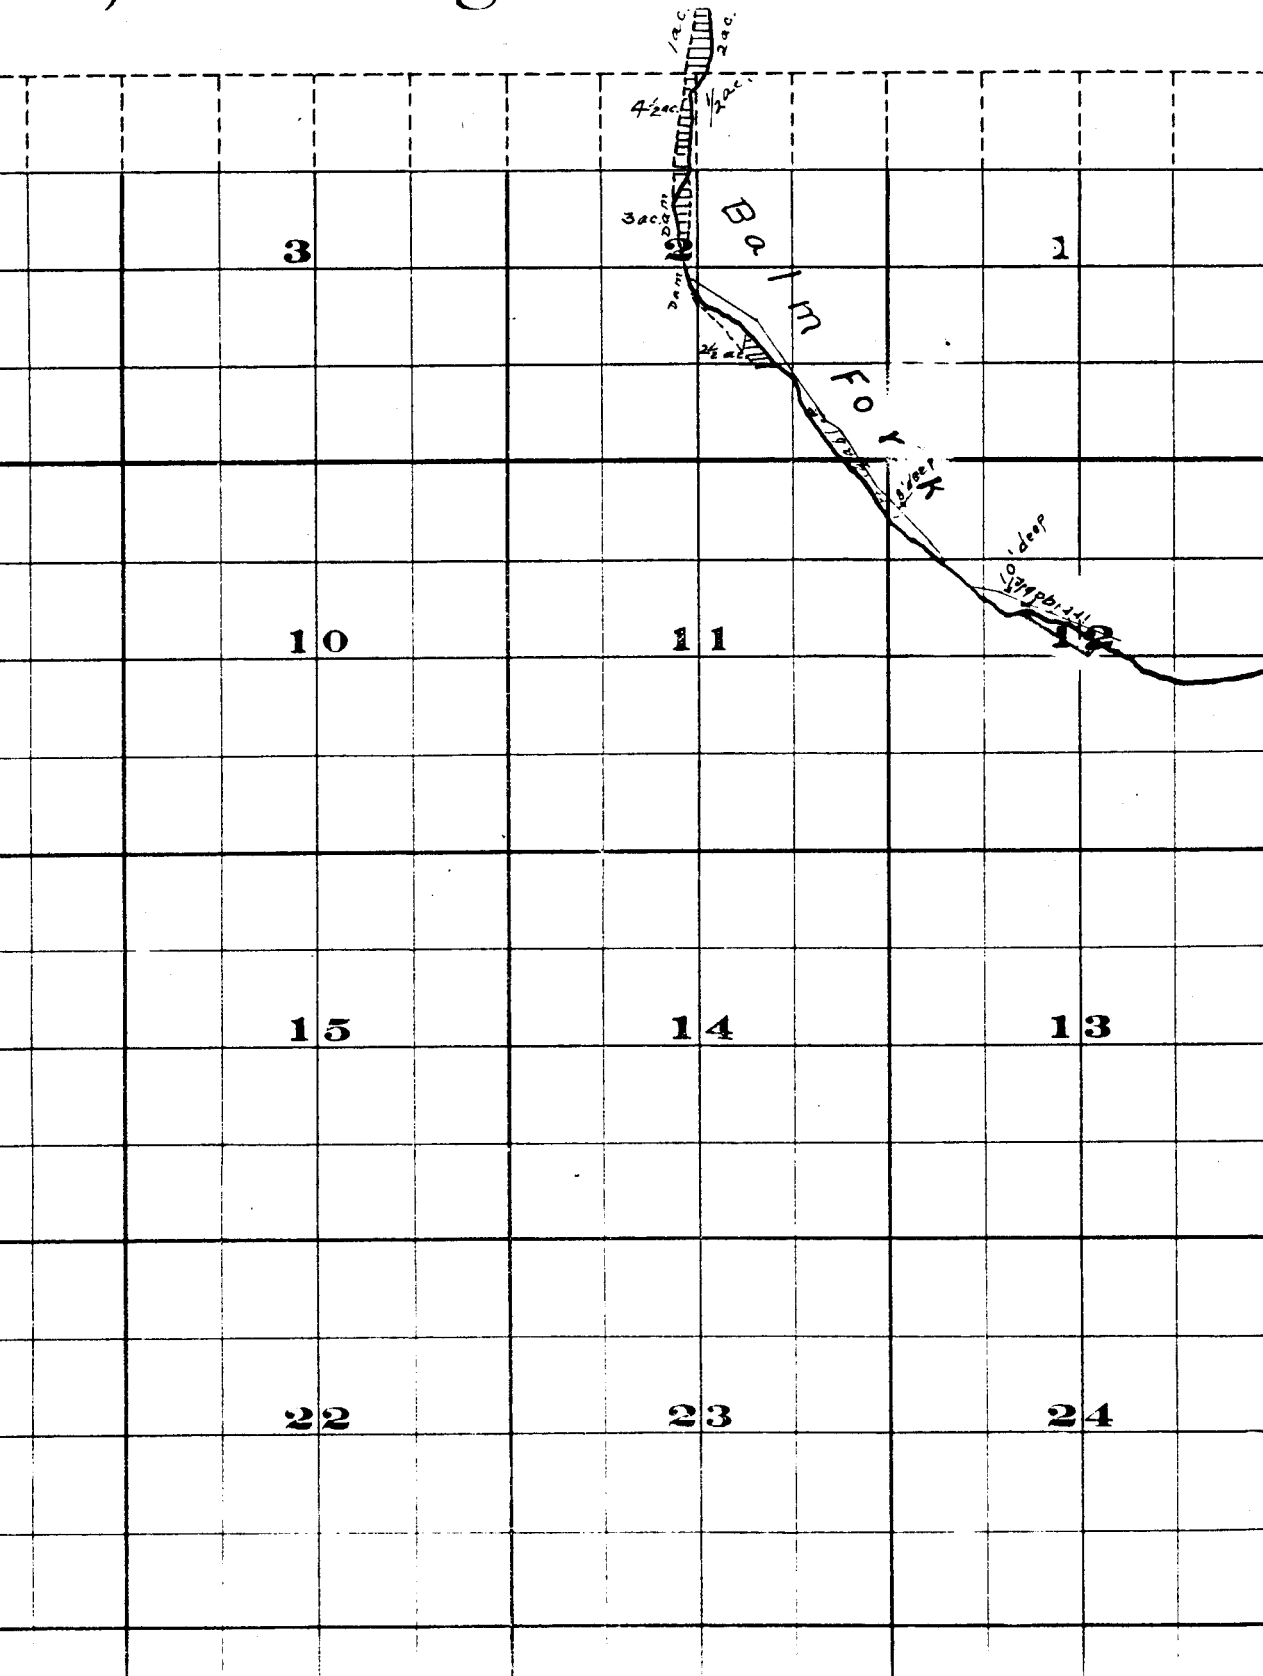

[illegible]

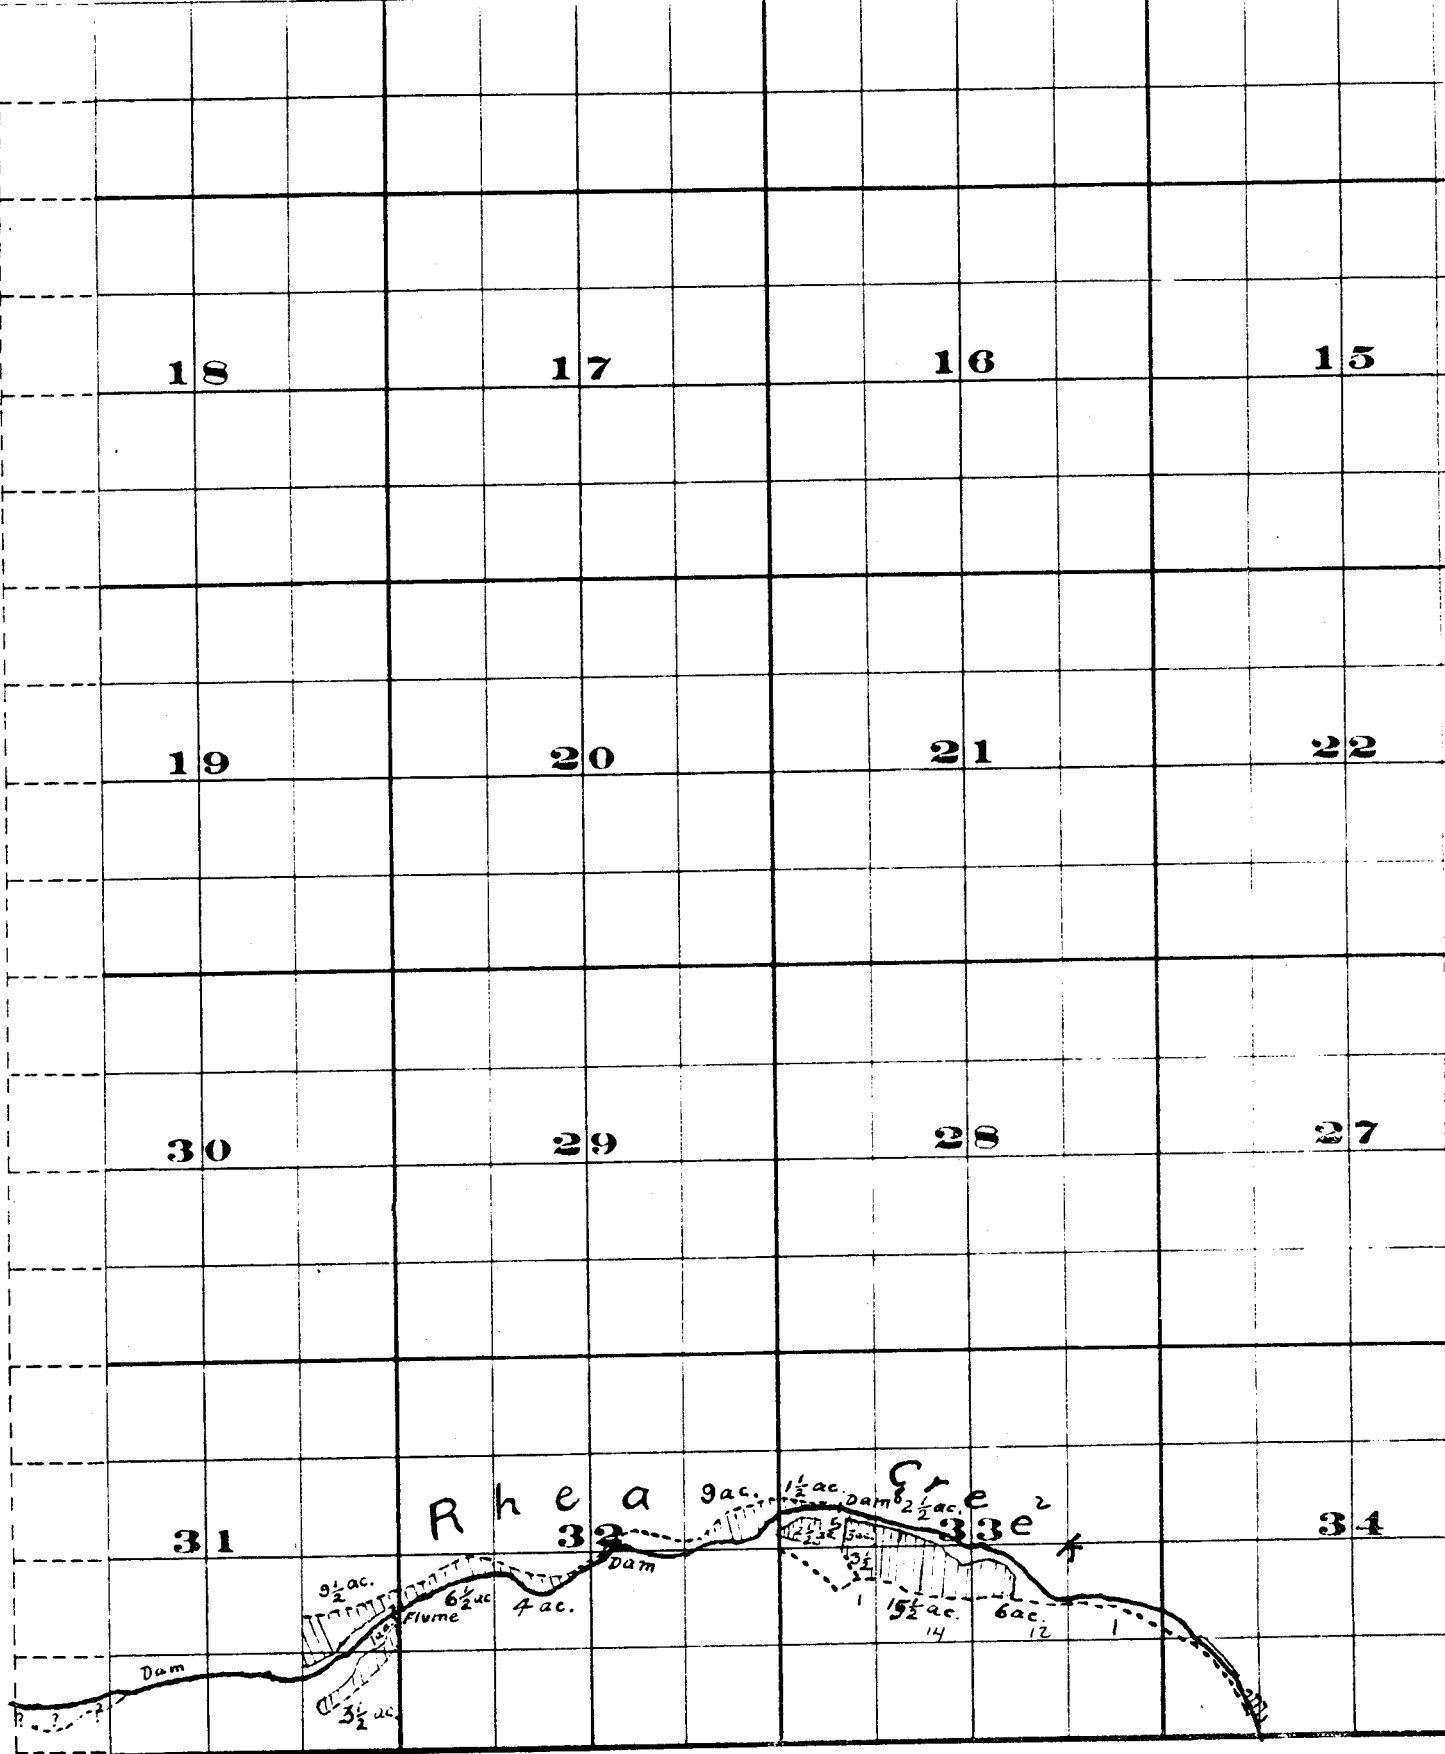

THE S. A. STOL CO. PRINTERS & BOOKBINDERS CHICAGO, ILL.

Surveyed by H.K. Donnelly July 1909

John H. Lewis - State Engineer

Examined - July 14, 1909.

	15			14			13		
	22			23			24		
	27			26			25		
	34			35			36		

FROM OFFICE OF THE STATE ENGINEER, SALEM, OREGON

Willow Creek Adjudication

3 S. 26 E.